

MAY 15 1997

CHEBOYGAN COUNTY REMONUMENTATION CORNER

LAND CORNER RECORDATION CERTIFICATE
Filing Requirement of Act 74, Mich. P.A. 1970

COMMISSION
For corners in
CHEBOYGAN

(County)	Located In:	Corner Code #
1. Public Land Survey	T 38N R 3W	M-9
	T _____ R _____	_____
	T 38 R 2W	A-9
	T _____ R _____	_____
2. Property Controlling in Section	S _____ T _____ R _____	_____
	S _____ T _____ R _____	_____
3. Miscellaneous Property in Sec.	S _____ T _____ R _____	_____
	S _____ T _____ R _____	_____

RECEIVED
FOR RECORD
96 OCT 30 PM 12:18
James Gray
CLERK/REGISTER
CHEBOYGAN COUNTY, MICHIGAN
Register of Deeds Stamp & File Number

4. Lot No. _____, Recorded Plat _____
5. Private Claims _____

I, JAMES H. GRANGER, in a field survey on SEPTEMBER 24, 19 96 do hereby state that under requirements of P.A. 74, Michigan P.A. of 1970, the corner points mentioned in lines 1 and 2 above were in conformance with regulations and rules therefore as required in the current manual of survey instructions of the United States Department of the Interior, Bureau of Land Management or by a decree of a Court of Law and /or that the corner points mentioned in lines 3, 4 and 5 above were in conformance with the rules of the Michigan Board of Land Surveyors or by a Decree of a Court of Law; established, re-established, monumented, recovered, found as expressed below:

NOTE: Not more than 2 corners, all in the same town and range, may be recorded on this certificate.

	A	B	C	D	E	F	G	H	I	J	K	L	M
1													
2	6	5	4	3	2	1							
3													
4	7	8	9	10	11	12							
5													
6	18	17	16	15	14	13							
7													
8	19	20	21	22	23	24							
9													
10	30	29	28	27	26	25							
11													
12	31	32	33	34	35	36							
13													

A. Description of original monument and accessories and/or subsequent restoration:

- 1840 Original Survey John Mullett: Set wood post 12" Cedar S17°W 27 lks, 8" Cedar N65°E 5 lks
- 1964 DNR - LCRC Ken Larsen # 10695: Set 1" pipe w/4" brass cap

B. Description of corner evidence found and/or method applied in restoring or reestablishing corner:

Found 1/2" iron with cap number 25785/21568 and DNR witness.



LIBER 010 PAGE 176

C. Description of monument for corner and accessories established to perpetuate locating the position of the corner:

also corner A-9, T38N, R2W

Set 5/8" x 30" rebar with Remonumentation Cap

- 1/2" Iron
- 14" Cedar N42°W 42.47' Set nail w/tag
- 10" Spruce S16°W 32.45' Fd. nail
- 4" Balsam N77°E 21.26' Set nail w/tag
- 18" White Pine S46°E 66.90' Set nail w/tag

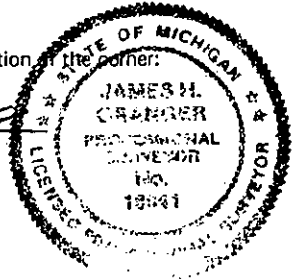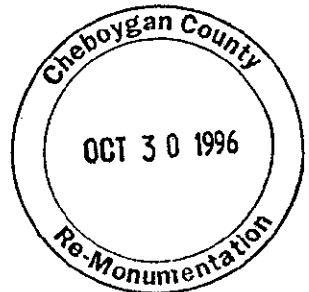

Signed by James H. Granger
Surveyor's Michigan License No. 16041

Date 10-10-96