

MAY 18 1997

CHEBOYGAN COUNTY REMONUMENTATION CORNER

LAND CORNER RECORDATION CERTIFICATE  
Filing Requirement of Act 74, Mich. P.A. 1970

CHEBOYGAN  
For Counties of  
CHEBOYGAN

|                                    |                                     |               |
|------------------------------------|-------------------------------------|---------------|
|                                    | Located In:                         | Corner Code # |
| 1. Public Land Survey              | T <u>38</u> N R <u>2W</u>           | <u>M-10</u>   |
|                                    | T <u>38</u> R <u>2W</u>             | <u>A-10</u>   |
|                                    | T <u>  </u> R <u>  </u>             | <u>  </u>     |
| 2. Property Controlling in Section | S <u>  </u> T <u>  </u> R <u>  </u> | <u>  </u>     |
|                                    | S <u>  </u> T <u>  </u> R <u>  </u> | <u>  </u>     |
| 3. Miscellaneous Property in Sec.  | S <u>  </u> T <u>  </u> R <u>  </u> | <u>  </u>     |
|                                    | S <u>  </u> T <u>  </u> R <u>  </u> | <u>  </u>     |

RECEIVED FOR RECORD  
96 OCT 30 PH12:19  
*Joanna Spray*  
CLERK/REGISTER  
CHEBOYGAN COUNTY, MICHIGAN  
Register of Deeds Stamp & File Number

4. Lot No. \_\_\_\_\_, Recorded Plat \_\_\_\_\_  
5. Private Claims \_\_\_\_\_

|    |    |    |    |    |    |    |   |   |   |   |   |   |
|----|----|----|----|----|----|----|---|---|---|---|---|---|
| A  | B  | C  | D  | E  | F  | G  | H | I | J | K | L | M |
| 1  |    |    |    |    |    |    |   |   |   |   |   |   |
| 2  | 6  | 5  | 4  | 3  | 2  | 1  |   |   |   |   |   |   |
| 3  |    |    |    |    |    |    |   |   |   |   |   |   |
| 4  | 7  | 8  | 9  | 10 | 11 | 12 |   |   |   |   |   |   |
| 5  |    |    |    |    |    |    |   |   |   |   |   |   |
| 6  | 18 | 17 | 16 | 15 | 14 | 13 |   |   |   |   |   |   |
| 7  |    |    |    |    |    |    |   |   |   |   |   |   |
| 8  | 19 | 20 | 21 | 22 | 23 | 24 |   |   |   |   |   |   |
| 9  |    |    |    |    |    |    |   |   |   |   |   |   |
| 10 | 30 | 29 | 28 | 27 | 26 | 25 |   |   |   |   |   |   |
| 11 |    |    |    |    |    |    |   |   |   |   |   |   |
| 12 | 31 | 32 | 33 | 34 | 35 | 36 |   |   |   |   |   |   |
| 13 |    |    |    |    |    |    |   |   |   |   |   |   |

I, JAMES H. GRANGER, in a field survey on SEPTEMBER 24, 1996 do hereby state that under requirements of P.A. 74, Michigan P.A. of 1970, the corner points mentioned in lines 1 and 2 above were in conformance with regulations and rules therefore as required in the current manual of survey instructions of the United States Department of the Interior, Bureau of Land Management or by a decree of a Court of Law and /or that the corner points mentioned in lines 3, 4 and 5 above were in conformance with the rules of the Michigan Board of Land Surveyors or by a Decree of a Court of Law; established, re-established, monumented, recovered, found as expressed below:

NOTE: Not more than 2 corners, all in the same town and range, may be recorded on this certificate.


A. Description of original monument and accessories and/or subsequent restoration:

1840 Original Survey                      Set wood post 10" Tamarack S50°W 8 lks  
John Mullett                                      8" Cedar                      N51°E 20 lks

B. Description of corner evidence found and/or method applied in restoring or reestablishing corner:

Found 1/2" iron with cap # 25785/21568 and four witnesses.

*Maurice P...*

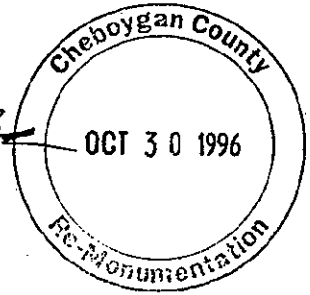

LIBER 010 PAGE 177


C. Description of monument for corner and accessories established to perpetuate locating the position of the corner

also corner A-10, T38N, R2W

Set 5/8" x 30" rebar with Remonumentation Cap

1/2" Iron  
14" Cedar                      N09°W                      8.74'                      Fd tag  
8" Cedar                      N45°E                      18.93'                      Fd tag  
8" Cedar                      S55°E                      13.72'                      Fd tag  
4" Cedar                      S31°W                      9.36'                      Fd tag

*Maurice P...*

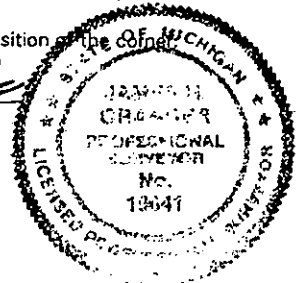

Signed by James H. Granger  
Surveyor's Michigan License No. 16041

Date 10-10-96