

MAY 05 1997

LAND CORNER RECORDATION CERTIFICATE
 Filing Requirement of Act 74, Mich. P.A. 1970

For corners in
CHEBOYGAN
COMMISSION

(County)

Located In: Corner Code #

- | | | |
|------------------------------------|----------------------------|-------------|
| 1. Public Land Survey | T <u>38</u> N R. <u>2W</u> | <u>M-11</u> |
| | T <u>38</u> R. <u>2W</u> | <u>A-11</u> |
| | T _____ R _____ | _____ |
| | T _____ R _____ | _____ |
| 2. Property Controlling in Section | S _____ T _____ R _____ | _____ |
| | S _____ T _____ R _____ | _____ |
| 3. Miscellaneous Property in Sec. | S _____ T _____ R _____ | _____ |
| | S _____ T _____ R _____ | _____ |

RECEIVED FOR RECORD
 96 OCT 30 PM 12:20

Joanna Spray
 CLERK/REGISTER
 CHEBOYGAN COUNTY, MICHIGAN
 Register of Deeds Stamp & File Number

4. Lot No. _____, Recorded Plat _____
5. Private Claims _____

	A	B	C	D	E	F	G	H	I	J	K	L	M
1													
2	6		5		4		3		2		1		
3													
4	7		8		9		10		11		12		
5													
6	18		17		16		15		14		13		
7													
8	19		20		21		22		23		24		
9													
10	30		29		28		27		26		25		
11													
12	31		32		33		34		35		36		
13													

I, JAMES H. GRANGER, in a field survey on SEPTEMBER 24, 1996 do hereby state that under requirements of P.A. 74, Michigan P.A. of 1970, the corner points mentioned in lines 1 and 2 above were in conformance with regulations and rules therefore as required in the current manual of survey instructions of the United States Department of the Interior, Bureau of Land Management or by a decree of a Court of Law and /or that the corner points mentioned in lines 3, 4 and 5 above were in conformance with the rules of the Michigan Board of Land Surveyors or by a Decree of a Court of Law; established, re-established, monumented, recovered, found as expressed below:


NOTE: Not more than 2 corners, all in the same town and range, may be recorded on this certificate.

A. Description of original monument and accessories and/or subsequent restoration:

- | | |
|---------------------------------------|---|
| 1840 Original Survey
John Mullett | Set wood post 10" Cedar N12°E 17 lks
8" Ash S45°W 11 lks |
| 1964 DNR - LCRC
Ken Larsen # 10695 | Set 1" pipe w/4" brass cap |
| 1977 LCRC
Orlando Doyle # 7319 | Found 1" pipe w/brass cap |
| 1984 Survey
Orlando Doyle # 7319 | Found 1" pipe w/brass cap |

B. Description of corner evidence found and/or method applied in restoring or reestablishing corner:

Found concrete monument, Three DNR witnesses and one Doyle Witness. *Marvin P. Rose*

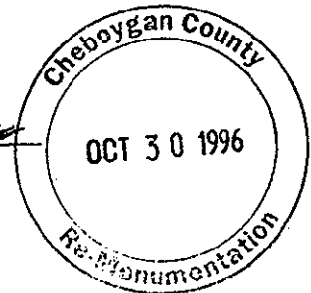


LIBER 010 PAGE 178

C. Description of monument for corner and accessories established to perpetuate locating the position of the corner:

also corner A-11, T38N, R2W

Concrete Monument with Remonumentation Cap

- | | | | |
|-----------|-------|--------|------------------|
| 14" Cedar | N33°W | 17.58' | Fd nail & washer |
| 5" Cedar | N50°E | 16.94' | Fd nail & washer |
| 18" Maple | S61°E | 45.43' | Fd spike |
| 8" Cedar | S20°E | 39.59' | Fd spike |

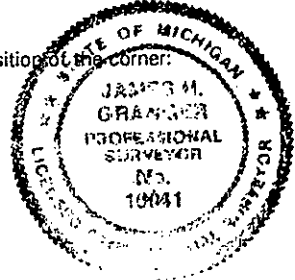

Signed by *James H. Granger*
 Surveyor's Michigan License No. 16041

Date 10-10-96