

REMONUMENTATION

MAY 15 1997

CHEBOYGAN COUNTY REMONUMENTATION CORNER

LAND CORNER RECORDATION CERTIFICATE
Filing Requirement of Act 74, Mich. P.A. 1970

CHEBOYGAN COMMISSION

(County) _____ Located in: _____ Corner Code # _____

1. Public Land Survey T 38N R 3W M-12
T R _____
T 38 R 2W A-12
T R _____
S T R _____
S T R _____
S T R _____

2. Property Controlling in Section _____
3. Miscellaneous Property in Sec. _____

4. Lot No. _____, Recorded Plat _____

5. Private Claims _____

RECEIVED FOR RECORD
96 OCT 30 PM 12: 22
James Granger
CLERK/REGISTER
CHEBOYGAN COUNTY, MICHIGAN
Register of Deeds Stamp & File Number

1	A	B	C	D	E	F	G	H	I	J	K	L	M
2													
3													
4	7	8	9	10	11	12							
5													
6	18	17	16	15	14	13							
7													
8	19	20	21	22	23	24							
9													
10	30	29	28	27	26	25							
11													
12	31	32	33	34	35	36							
13													

I, JAMES H. GRANGER, in a field survey on SEPTEMBER 24, 1996 do hereby state that under requirements of P.A. 74, Michigan P.A. of 1970, the corner points mentioned in lines 1 and 2 above were in conformance with regulations and rules therefore as required in the current manual of survey instructions of the United States Department of the Interior, Bureau of Land Management or by a decree of a Court of Law and for that the corner points mentioned in lines 3, 4 and 5 above were in conformance with the rules of the Michigan Board of Land Surveyors or by a Decree of a Court of Law; established, re-established, monumented, recovered, found as expressed below:

NOTE: Not more than 2 corners, all in the same town and range, may be recorded on this certificate.

A. Description of original monument and accessories and/or subsequent restoration:


- 1840 Original Survey John Mullett Set wood post 24" Sugar N28°W 21 lks
24" Lynn S48°E 32 lks
- 1972 Survey Orlando Doyle # 7319 1" pipe
- 1987 Survey Orlando Doyle # 7319 1" pipe

B. Description of corner evidence found and/or method applied in restoring or reestablishing corner:

Found 3/4" pipe and three Doyle witnesses.

Monumented


LIBER 010 PAGE 179

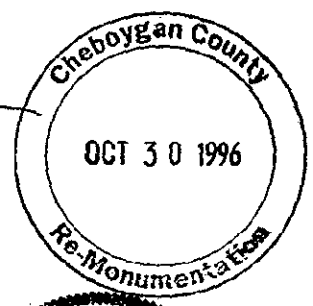

C. Description of monument for corner and accessories established to perpetuate locating the position of the corner:

also corner A-12, T38N, R2W
Set 5/8" x 30" rebar with Remonumentation Cap

- 10" Cedar S36°E 83.13' Fd tag
- 4" Maple N30°E 25.74' Set nail w/tag
- 6" S. Pine N75°W 26.95' Fd tag
- 6" S. Pine N40°W 19.87' Fd tag

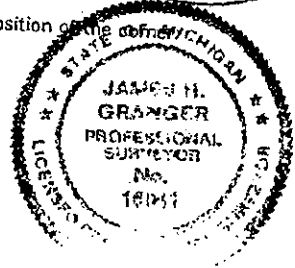

Signed by James H. Granger
Surveyor's Michigan License No. 16041

Date 10-10-96