

SURVEY & REMONUMENTATION

CHEBOYGAN COUNTY REMONUMENTATION CORNER

FEB 26 1998

LAND CORNER RECORDATION CERTIFICATE
Filing Requirement of Act 74, Mich. P.A. 1970

For corners in
SECTION
CHEBOYGAN
(County)

Located In: 38N 2W
Corner Code # B-13
B-1
T 37N R 2W
T R
T R
T R
S T R
S T R
S T R
S T R

RECEIVED FOR RECORD 1278-9
at 11:20 O'Clock A M
Joanne Spray
CLERK/REGISTER
CHEBOYGAN COUNTY, MICHIGAN
Register of Deeds Stamp & File Number

- 1. Public Land Survey
- 2. Property Controlling in Section
- 3. Miscellaneous Property in Sec.
- 4. Lot No. Recorded Plat
- 5. Private Claims


I, JAMES H. GRANGER, in a field survey on JULY 15, 19 97 do hereby state that under requirements of P.A. 74, Michigan P.A. of 1970, the corner points mentioned in lines 1 and 2 above were in conformance with regulations and rules therefore as required in the current manual of survey instructions of the United States Department of the Interior, Bureau of Land Management or by a decree of a Court of Law and /or that the corner points mentioned in lines 3, 4 and 5 above were in conformance with the rules of the Michigan Board of Land Surveyors or by a Decree of a Court of Law; established, re-established, monumented, recovered, found as expressed below:

NOTE: Not more than 2 corners, all in the same town and range, may be recorded on this certificate.

A	B	C	D	E	F	G	H	I	J	K	L	M
1												
2	6	5	4	3	2	1						
3												
4	7	8	9	10	11	12						
5												
6	18	17	16	15	14	13						
7												
8	19	20	21	22	23	24						
9												
10	30	29	28	27	26	25						
11												
12	31	32	33	34	35	36						
13												

A. Description of original monument and accessories and/or subsequent restoration:

- B-1 1840 Original Survey John Mullett Set wood post 40" Hemlock 12" Birch N45°W 11 lks N42°E 10 lks
- 1972 Survey Orlando Doyle #7319 Metal Monument
- 1977 LCRC Orlando Doyle #7319 1 1/4" Pipe
- 1985 Survey Orlando Doyle #7319 Metal Monument

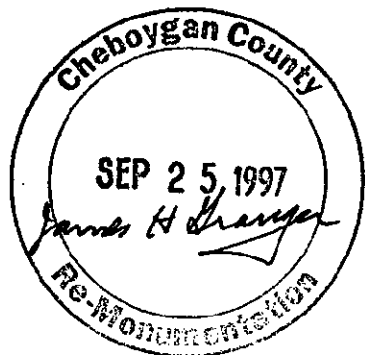

B. Description of corner evidence found and/or method applied in restoring or reestablishing corner:

- B-1 No evidence of monument found. Found 2 witnesses, grown over, per Doyle LCRC. Set 5/8" rebar and remonumentation cap per existing witnesses.

C. Description of monument for corner and accessories established to perpetuate locating the position of the corner:

- B-1 5/8" rebar and Remonumentation Cap
- 14" Pine S52°W 43.27' Set tag #16041
- PP S 6°W 31.79' Set tag #16041
- 14" Pine N50°E 44.46' Set tag #16041
- 8" Pine N28°W 22.52' Set tag #16041

LIBER 011 PAGE 24

Signed by James H. Granger License No. 16041

Date Nov. 17, 1997 Surveyor's Michigan

