

CHEBOYGAN COUNTY
REMONUMENTATION CORNER

SURVEY &
REMONUMENTATION

MAR 22 1999

LAND CORNER RECORDATION CERTIFICATE
Filing Requirement of Act 74, Mich. P.A. 1970

For corners in

<u>CHEBOYGAN</u> (County)	SECTION	Located In:	Corner Code #
1. Public Land Survey	T <u>38NR 2W</u>		<u>C-2</u>
	T <u> </u> R <u> </u>		
	T <u> </u> R <u> </u>		
	T <u> </u> R <u> </u>		
2. Property Controlling in Section	S <u> </u> T <u> </u> R <u> </u>		
	S <u> </u> T <u> </u> R <u> </u>		
3. Miscellaneous Property in Sec.	S <u> </u> T <u> </u> R <u> </u>		
	S <u> </u> T <u> </u> R <u> </u>		

RECEIVED FOR RECORD 12-7-98
of 9:09 O'Clock A M

Joanne Spray


CLERK/REGISTER
CHEBOYGAN COUNTY, MICHIGAN

Register of Deeds Stamp & File Number

4. Lot No. _____, Recorded Plat _____
5. Private Claims _____

I, JAMES H. GRANGER, in a field survey on July 15, 1998 do hereby state that under requirements of P.A. 74, Michigan P.A. of 1970, the corner points mentioned in lines 1 and 2 above were in conformance with regulations and rules therefore as required in the current manual of survey instructions of the United States Department of the Interior, Bureau of Land Management or by a decree of a Court of Law and/or that the corner points mentioned in lines 3, 4 and 5 above were in conformance with the rules of the Michigan Board of Land Surveyors or by a Decree of a Court of Law; established, re-established, monumented, recovered, found as expressed below:

NOTE: Not more than 2 corners, all in the same town and range, may be recorded on this certificate.

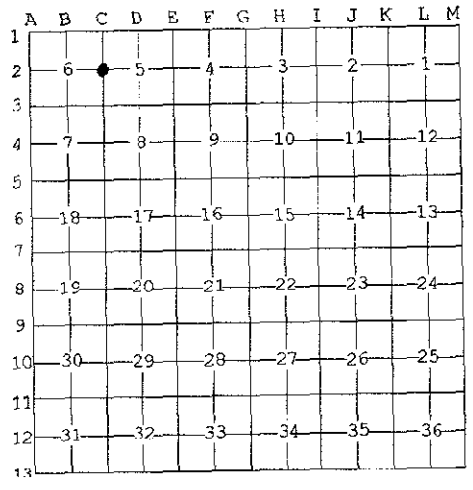


A. Description of original monument and accessories and/or subsequent restoration:

1856 Original survey Harvey Mellen Set Wood Post 20" Cedar N10°E 15 lks 20" Cedar N8°W 18 lks	1976 Survey Orlando Doyle #7319 1" axle and 3 witnesses	1981 Survey Orlando Doyle #7319 1" axle
--	--	--

B. Description of corner evidence found and/or method applied in restoring or reestablishing corner:

Fd 1" axle and 3 witnesses.

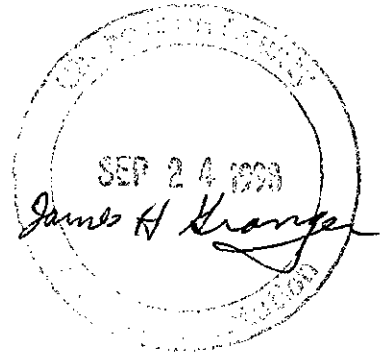

C. Description of monument for corner and accessories established to perpetuate locating the position of the corner:

Removed 1" axle and set 5/8" rebar and remonumentation cap

6" Birch	S21°W	5.94'	Fd tag
10" Birch	S67°W	25.12'	Fd tag
14" Birch	N27°E	14.54'	Fd tag
8" Birch	N78°E	24.35'	Set tag #16041



Signed by James H. Granger
License No. 16041

Date November 2, 1998 Surveyor's Michigan