

MAR 22 1999

LAND CORNER RECORDATION CERTIFICATE Filing Requirement of Act 74, Mich. P.A. 1970

For corners in SECTION

Table with columns: CHEBOYGAN (County), Located In, Corner Code #. Rows include Public Land Survey, Property Controlling in Section, and Miscellaneous Property in Sec.

RECEIVED FOR RECORD 12-7-98 of 9:10 O'Clock A.M.

Signature of Joanne Gray

CLERK/REGISTER CHEBOYGAN COUNTY, MICHIGAN

Register of Deeds Stamp & File Number

4. Lot No. , Recorded Plat
5. Private Claims

I, JAMES H. GRANGER, in a field survey on July 15, 19 98 do hereby state that under requirements of P.A. 74, Michigan P.A. of 1970, the corner points mentioned in lines 1 and 2 above were in conformance with regulations and rules therefore as required in the current manual of survey instructions of the United States Department of the Interior, Bureau of Land Management or by a decree of a Court of Law and/or that the corner points mentioned in lines 3, 4 and 5 above were in conformance with the rules of the Michigan Board of Land Surveyors or by a Decree of a Court of Law; established, re-established, monumented, recovered, found as expressed below:

NOTE: Not more than 2 corners, all in the same town and range, may be recorded on this certificate.

A. Description of original monument and accessories and/or subsequent restoration:

- 1856 Original survey Harvey Mellen Set Wood Post 9" Cedar S74°W 16 lks 9" Cedar N30°W 7 lks
1981 Survey Orlando Doyle #7319
1964 LCRC Kenneth Larsen #10695 Fd. 1" axle replaced with 4" Brass Cap
1996 LCRC Thomas #41100 Fd. DNR Brass Cap.

B. Description of corner evidence found and/or method applied in restoring or reestablishing corner:


Found 1" pipe with 4" brass cap and 4 witnesses.

C. Description of monument for corner and accessories established to perpetuate locating the position of the corner:

1" pipe with 4" brass cap

- 6" Balsam N81°W 8.98' Fd nail
8" Ash N21°W 19.56' Fd nail
5" Balsam S23°W 3.69' Fd nail
8" Ash N87°E 15.81' Fd nail

Grid table with columns A-M and rows 1-13. A dot is marked at row 3, column C.

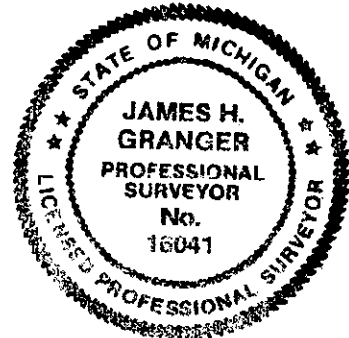

Signed by James H. Granger Date November 2, 1998 Surveyor's Michigan License No. 16041