

SURVEY & REMONUMENTATION

CHEBOYGAN COUNTY REMONUMENTATION CORNER

LAND CORNER RECORDATION CERTIFICATE
 Filing Requirement of Act 74, Mich. P.A. 1970

MAR 22 1999

For corners in

CHEBOYGAN SECTION Located In: _____ Corner Code # _____
 (County)

1. Public Land Survey T 38NR 2W _____ E-3
 T _____ R _____
 T _____ R _____
 T _____ R _____

2. Property Controlling S _____ T _____ R _____
 in Section S _____ T _____ R _____

3. Miscellaneous S _____ T _____ R _____
 Property in Sec. S _____ T _____ R _____


RECEIVED FOR RECORD 12-7-98
 at 9:12 O'Clock A. M

Joanne Gray

CLERK/REGISTER
 CHEBOYGAN COUNTY, MICHIGAN
 Register of Deeds Stamp & File Number

4. Lot No. _____, Recorded Plat _____
 5. Private Claims _____

I, JAMES H. GRANGER, in a field survey on JULY 15, 19 98 do hereby state that under requirements of P.A. 74, Michigan P.A. of 1970, the corner points mentioned in lines 1 and 2 above were in conformance with regulations and rules therefore as required in the current manual of survey instructions of the United States Department of the Interior, Bureau of Land Management or by a decree of a Court of Law and for that the corner points mentioned in lines 3, 4 and 5 above were in conformance with the rules of the Michigan Board of Land Surveyors or by a Decree of a Court of Law; established, re-established, monumented, recovered, found as expressed below:

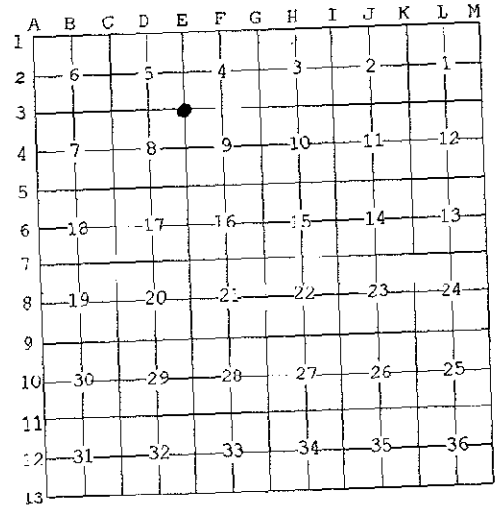

NOTE: Not more than 2 corners, all in the same town and range, may be recorded on this certificate.

A. Description of original monument and accessories and/or subsequent restoration:


- 1856 Original Survey Set wood post 8" Pine S88-1/2°W 44 lks
 Harvey Mellen 6" Pine N61°E 40 lks
- 1914 Plat Indicates Iron Monument N. Side of Highway
 Arthur Watson, Jr.
- 1982 LCRC Set 1" pipe
 Orlando Doyle #7319
- 1986 Survey Found 1" pipe set by Doyle
 Norman Quaine #33984
- 1986 Survey Found and verified 1" pipe
 Robert Mitchell #28417
- 1987 Plat Shows corner
 Royal Grant #1
- 1988 Survey Found 1" pipe
 James H. Granger #16041
- 1988 LCRC 1" pipe
 James H. Granger #16041
- 1990 LCRC 1" pipe by Doyle
 Norman Quaine #33984

B. Description of corner evidence found and/or method applied in restoring or reestablishing corner:

Found 1" pipe consistent with existing monumentation from Plat of Point Nip-I-Gon on the Straits and 4 witnesses per Liber 1, Page 408.

C. Description of monument for corner and accessories established to perpetuate locating the position of the corner:

- Removed 1" pipe and set 5/8" rebar and Remonumentation Cap
- 14" Maple N53°W 3.10' Fd nail and washer
- 10" Pine N60°E 20.57' Fd nail and washer
- 14" Pine N15°W 53.77' Fd nail and washer
- 5" Pine S21°E 14.23' Fd nail and washer

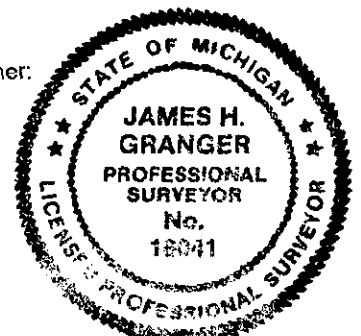

Signed by James H. Granger
 License No. 16041

Date November 2, 1998 Surveyor's Michigan