

MAR 22 1999

CHEBOYGAN COUNTY REMONUMENTATION CORNER

LAND CORNER RECORDATION CERTIFICATE  
Filing Requirement of Act 74, Mich. P.A. 1970

For corners in SECTION

<u>CHEBOYGAN</u> (County)	Located In:	Corner Code #
1. Public Land Survey	T <u>38NR</u> <u>2W</u>	<u>E-4</u>
	T ___ R ___	_____
	T ___ R ___	_____
	T ___ R ___	_____
2. Property Controlling in Section	S ___ T ___ R ___	_____
	S ___ T ___ R ___	_____
3. Miscellaneous Property in Sec.	S ___ T ___ R ___	_____
	S ___ T ___ R ___	_____

RECEIVED FOR RECORD 12-7-98  
at 9:13 O'Clock A. M

*Joanne Spray*

CLERK/REGISTER  
CHEBOYGAN COUNTY, MICHIGAN

Register of Deeds Stamp & File Number

4. Lot No. \_\_\_\_\_, Recorded Plat \_\_\_\_\_  
5. Private Claims \_\_\_\_\_

I, JAMES H. GRANGER, in a field survey on JULY 15, 19 98 do hereby state that under requirements of P.A. 74, Michigan P.A. of 1970, the corner points mentioned in lines 1 and 2 above were in conformance with regulations and rules therefore as required in the current manual of survey instructions of the United States Department of the Interior, Bureau of Land Management or by a decree of a Court of Law and /or that the corner points mentioned in lines 3, 4 and 5 above were in conformance with the rules of the Michigan Board of Land Surveyors or by a Decree of a Court of Law; established, re-established, monumented, recovered, found as expressed below:

NOTE: Not more than 2 corners, all in the same town and range, may be recorded on this certificate.

A. Description of original monument and accessories and/or subsequent restoration:

- 1856 Original Survey Harvey Mellen Set wood post 18" Pine S72°W 43 lks
- 1986 Survey Norman Quaine #33984 Found 1" pipe
- 1990 LCRC Norman Quaine #33984 1" pipe


B. Description of corner evidence found and/or method applied in restoring or reestablishing corner:

Found 1" pipe and 2 witnesses.

C. Description of monument for corner and accessories established to perpetuate locating the position of the corner:

- Removed 1" pipe and set 5/8" rebar and Remonumentation Cap
- 5" Balsam N70°W 10.18' Found tag
- 12" Spruce S86°E 8.75' Found tag
- 4" Balsam N16°E 13.50' Set tag #16041
- 5" Balsam S 9°W 18.65' Set tag #16041

	A	B	C	D	E	F	G	H	I	J	K	L	M
1													
2	6			5			4		3		2		1
3													
4	7			8			9		10		11		12
5													
6	18			17			16		15		14		13
7													
8	19			20			21		22		23		24
9													
10	30			29			28		27		26		25
11													
12	31			32			33		34		35		36
13													

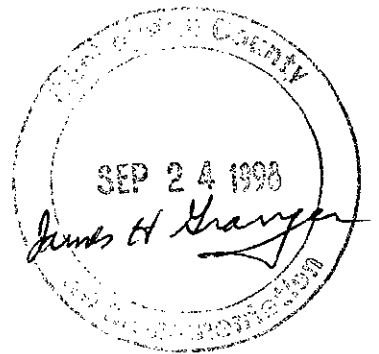

Signed by James H. Granger  
License No. 16041

Date November 2, 1998 Surveyor's Michigan

