

CHEBOYGAN COUNTY REMONUMENTATION CORNER

LAND CORNER RECORDATION CERTIFICATE
Filing Requirement of Act 74, Mich. P.A. 1970

corners in

CHEBOYGAN Located in: Corner Code #
(County)
Public Land Survey 38N 2W
T 37NR 2W
T R
T R
T R
Property Controlling S T R
in Section S T R
Miscellaneous S T R
Property in Sec. S T R

RECEIVED FOR RECORD 12-18-97
at 12:00 O'Clock A M

James H. Granger

CLERK/REGISTER
CHEBOYGAN COUNTY, MICHIGAN

Register of Deeds Stamp & File Number

Lot No. _____, Recorded Plat _____
Private Claims _____

JAMES H. GRANGER, in a field survey on JULY 15, 19 97 do hereby state
that under requirements of P.A. 74, Michigan P.A. of 1970, the corner points mentioned in lines 1 and 2 above
were in conformance with regulations and rules therefore as required in the current manual of survey
instructions of the United States Department of the Interior, Bureau of Land Management or by a decree of a
Court of Law and for that the corner points mentioned in lines 3, 4 and 5 above were in conformance with the
rules of the Michigan Board of Land Surveyors or by a Decree of a Court of Law, established, re-established,
remonumented, recovered, found as expressed below.

NOTE: Not more than 2 corners, all in the same town and range, may be recorded
on this certificate.

	A	B	C	D	E	F	G	H	I	J	K	L	M
1													
2	6		5		4		3		2		1		
3													
4	7		8		9		10		11		12		
5													
6	18		17		16		15		14		13		
7													
8	19		20		21		22		23		24		
9													
10	30		29		28		27		26		25		
11													
12	31		32		33		34		35		36		
13													


Description of original monument and accessories and/or subsequent restoration:

- 1840 Original Survey Set wood post 8" Spruce N67°W 21 lks
John Mullett 6" Spruce N64°E 8 lks
- 1955 LCRC Iron marked wood stake
Orlando Doyle #7319

SURVEY &
REMONUMENTATION

FEB 26 1998

SECTION

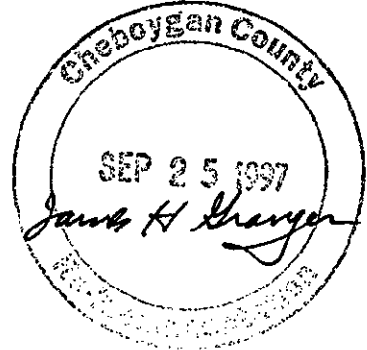

Description of corner evidence found and/or method applied in restoring or reestablishing corner:


- 1 Found 1/2" iron with cap #12020 and remains of old squared wood post in marsh at corner position.
Replaced with 5/8" rebar and remonumentation cap.

Description of monument for corner and accessories established to perpetuate locating the position of the corner:

- 1 5/8" rebar and Remonumentation Cap
20" W. Pine N83°E 14.85' Set tag #16041
3" Spruce S51°E 2.39' Set tag #16041
8" Spruce S13°W 28.51' Set tag #16041
3" Spruce N19°W 21.46' Set tag #16041

Signed by James H. Granger
License No. 16041

Date Nov. 17, 1997 Surveyor's Michigan

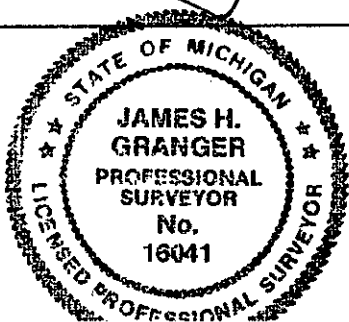

FORM APPROVED BY MICHIGAN STATE BOARD OF PROFESSIONAL SURVEYORS, JAN. 28, 1971
REVISED 44, 1978

REVISED JAN., 1993
REVISED OCT., 1996