

SURVEY & REMONUMENTATION

MAR 22 1999

**CHEBOYGAN COUNTY
REMONUMENTATION CORNER**

SECTION

**LAND CORNER RECORDATION CERTIFICATE
Filing Requirement of Act 74, Mich. P.A. 1970**

For corners in

<u>CHEBOYGAN</u> (County)	Located in:	Corner Code #
1. Public Land Survey	T <u>38N</u> R <u>2W</u>	<u>F-5</u>
	T <u> </u> R <u> </u>	<u> </u>
	T <u> </u> R <u> </u>	<u> </u>
	T <u> </u> R <u> </u>	<u> </u>
2. Property Controlling in Section	S <u> </u> T <u> </u> R <u> </u>	<u> </u>
	S <u> </u> T <u> </u> R <u> </u>	<u> </u>
3. Miscellaneous Property in Sec.	S <u> </u> T <u> </u> R <u> </u>	<u> </u>
	S <u> </u> T <u> </u> R <u> </u>	<u> </u>
4. Lot No. _____, Recorded Plat _____		
5. Private Claims _____		

RECEIVED FOR RECORD 12-7-98
at 9:16 O'Clock A M

Joanne Spray

CLERK/REGISTER
CHEBOYGAN COUNTY, MICHIGAN

Register of Deeds Stamp & File Number


1	A	B	C	D	E	F	G	H	I	J	K	L	M
2	6	5	4	3	2	1							
3													
4	7	8	9	10	11	12							
5													
6	18	17	16	15	14	13							
7													
8	19	20	21	22	23	24							
9													
10	30	29	28	27	26	25							
11													
12	31	32	33	34	35	36							
13													

I, JAMES H. GRANGER, in a field survey on July 15, 1998, do hereby state that under requirements of P.A. 74, Michigan P.A. of 1970, the corner points mentioned in lines 1 and 2 above were in conformance with regulations and rules therefore as required in the current manual of survey instructions of the United States Department of the Interior, Bureau of Land Management or by a decree of a Court of Law and/or that the corner points mentioned in lines 3, 4 and 5 above were in conformance with the rules of the Michigan Board of Land Surveyors or by a Decree of a Court of Law; established, re-established, monumented, recovered, found as expressed below:

NOTE: Not more than 2 corners, all in the same town and range, may be recorded on this certificate.

A. Description of original monument and accessories and/or subsequent restoration:

- 1856 Original survey Harvey Mellen Set Wood Post 30" Pine S47.5°W 1.88 lks
- 1966 LCRC Kenneth Larsen #10659 Set 1" pipe with 4" aluminum cap
- 1976 Survey Orlando Doyle #7319 Indicates Monument
- 1985 LCRC Orlando Doyle #7319 1" pipe with 4" aluminum cap
- 1990 LCRC Norman Quaine #33984 1" pipe with 4" aluminum cap
- 1992 Survey James H. Granger Fd 1" pipe with 4" aluminum cap

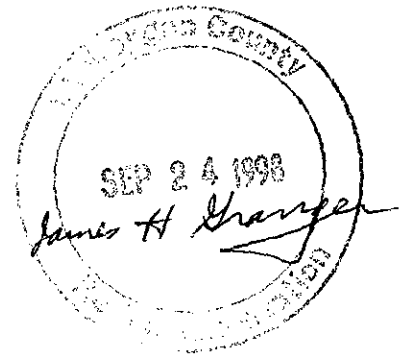

B. Description of corner evidence found and/or method applied in restoring or reestablishing corner:

Found 1" pipe with 4" aluminum cap.



C. Description of monument for corner and accessories established to perpetuate locating the position of the corner:

1" pipe with 4" aluminum cap

- 4" Balsam N34°E 7.92' Set tag #16041
- 8" Poplar S60°E 11.71' Set tag #16041
- 2" Balsam S10°W 26.48' Set tag #16041
- 12" Poplar S64°W 62.73' Set tag #16041

Signed by James H. Granger
License No. 16041

Date November 2, 1998 Surveyor's Michigan