

MAR 22 1999

SECTION

LAND CORNER RECORDATION CERTIFICATE
Filing Requirement of Act 74, Mich. P.A. 1970

For corners in

<u>CHEBOYGAN</u> (County)	Located In:	Corner Code #
1. Public Land Survey	T <u>38N</u> R <u>2W</u>	<u>G-5</u>
	T _____ R _____	_____
	T _____ R _____	_____
	T _____ R _____	_____
2. Property Controlling in Section	S _____ T _____ R _____	_____
	S _____ T _____ R _____	_____
3. Miscellaneous Property in Sec.	S _____ T _____ R _____	_____
	S _____ T _____ R _____	_____

RECEIVED FOR RECORD 12-7-98
at 9:18 O'Clock A. M

Joanne Spray

CLERK/REGISTRAR
CHEBOYGAN COUNTY, MICHIGAN

Register of Deeds Stamp & File Number

4. Lot No. _____, Recorded Plat _____
5. Private Claims _____


I, JAMES H. GRANGER, in a field survey on July 15, 1998 do hereby state that under requirements of P.A. 74, Michigan P.A. of 1970, the corner points mentioned in lines 1 and 2 above were in conformance with regulations and rules therefore as required in the current manual of survey instructions of the United States Department of the Interior, Bureau of Land Management or by a decree of a Court of Law and /or that the corner points mentioned in lines 3, 4 and 5 above were in conformance with the rules of the Michigan Board of Land Surveyors or by a Decree of a Court of Law; established, re-established, monumented, recovered, found as expressed below:

A	B	C	D	E	F	G	H	I	J	K	L	M
1												
2	6	5	4	3	2	1						
3												
4	7	8	9	10	11	12						
5												
6	18	17	16	15	14	13						
7												
8	19	20	21	22	23	24						
9												
10	30	29	28	27	26	25						
11												
12	31	32	33	34	35	36						
13												

NOTE: Not more than 2 corners, all in the same town and range, may be recorded on this certificate.

A. Description of original monument and accessories and/or subsequent restoration:

- | | |
|---|------------------------------------------------------------------|
| 1856 Original survey Harvey Mellen
Set Wood Post
36" Pine N52°E 21 lks
30" Pine N30°W 48 lks | 1966 Plat Birchwood Estates
Indicates Corner |
| 1948 Survey Orlando Doyle #7319
Set 1" Pipe | 1985 LCRC Orlando Doyle #7319
1" Pipe w/4" aluminum cap |
| 1957 Survey Orlando Doyle #7319
1" pipe | 1990 LCRC Norman Quaine #33984
1" Pipe w/4" aluminum cap |
| 1964 LCRC Kenneth Larsen #10695
Fd 1" pipe replaced with 1" pipe with
4" aluminum cap | 1992 Survey James H. Granger #16041
1" Pipe w/4" aluminum cap |

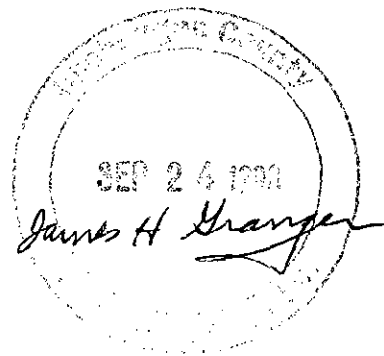


B. Description of corner evidence found and/or method applied in restoring or reestablishing corner:

Found 1" pipe with 4" aluminum cap.

C. Description of monument for corner and accessories established to perpetuate locating the position of the corner:

1" pipe with 4" aluminum cap

- | | |
|------------|--------------------------------|
| 18" Poplar | N50°E 18.74' set tag #16041 |
| 6" Maple | N58°W 18.96' nail & tag #16041 |
| 8" Balsam | S53°W 18.72' fd tag |
| 6" Maple | S34°W 13.41' fd tag |

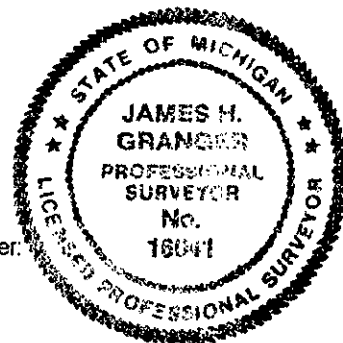

Signed by James H. Granger Date November 2, 1998 Surveyor's Michigan
License No. 16041