SURVEY & REMONUMENTATION

MAR 2 2 1999

# CHEBOYGAN COUNTY REMONUMENTATION CORNER

## LAND CORNER RECORDATION CERTIFICATE
**Filing Requirement of Act 74, Mich. P.A. 1970**

For corners in SECTION

CHEBOYGAN (County) Located In: Corner Code #

RECEIVED FOR RECORD 12-7-98
at 9:19 O'Clock A. M

Joanne Spray
CLERK/REGISTER
CHEBOYGAN COUNTY, MICHIGAN

**Register of Deeds Stamp & File Number**

| | | | | |
|---|---|---|---|---|
| 1. Public Land Survey | | T 38N | R 2W | G-6 |
| | | T___ | R___ | |
| | | T___ | R___ | |
| | | T___ | R___ | |
| 2. Property Controlling | S___ | T___ | R___ | |
| in Section | S___ | T___ | R___ | |
| 3. Miscellaneous | S___ | T___ | R___ | |
| Property in Sec. | S___ | T___ | R___ | |

4. Lot No. _____ , Recorded Plat _____
5. Private Claims _____

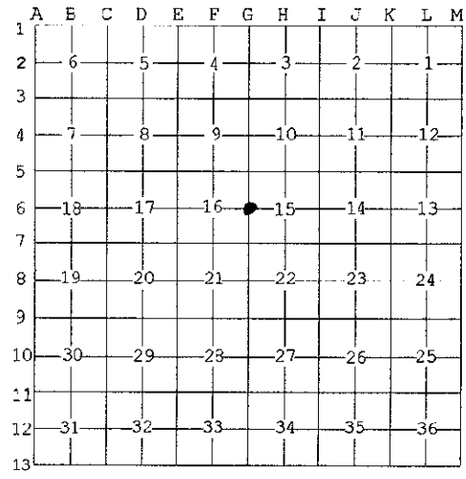


I, JAMES H. GRANGER, in a field survey on JULY 15, 19 98 do hereby state that under requirements of P.A. 74, Michigan P.A. of 1970, the corner points mentioned in lines 1 and 2 above were in conformance with regulations and rules therefore as required in the current manual of survey instructions of the United States Department of the Interior, Bureau of Land Management or by a decree of a Court of Law and /or that the corner points mentioned in lines 3, 4 and 5 above were in conformance with the rules of the Michigan Board of Land Surveyors or by a Decree of a Court of Law; established, re-established, monumented, recovered, found as expressed below:

**NOTE: Not more than 2 corners, all in the same town and range, may be recorded on this certificate.**

A. Description of original monument and accessories and/or subsequent restoration:

| | | | | |
|---|---|---|---|---|
| 1856 Original Survey Harvey Mellen | Set wood post | 9" Pine | N63°E | 20 lks |
| | | 40" Pine | N16°W | 1.10 chs |
| 1948 LCRC Orlando Doyle #7319 | Set ½" pipe | | | |
| 1989 Survey Dwight Schofield #34976 | Found ½" pipe | | | |
| 1990 LCRC Dwight Schofield #34976 | ½" pipe | | | |

Cheboygan County
SEP 2 4 1998
James H Granger

B. Description of corner evidence found and/or method applied in restoring or reestablishing corner:

Found ½" pipe and 2 witnesses, 1 overgrown.

C. Description of monument for corner and accessories established to perpetuate locating the position of the corner:

Removed ½" pipe and set 5/8" rebar and Remonumentation Cap

| | | | |
|---|---|---|---|
| 3/4" Pipe | N34°W | 50.16' | |
| 8" Poplar | S40°W | 47.32' | Set tag #16041 |
| 10" Cedar | West | 30.72' | Set tag #16041 |
| 6" Birch | S42°E | 81.56' | Set tag #16041 |

STATE OF MICHIGAN
JAMES H. GRANGER
PROFESSIONAL SURVEYOR
No. 16041
LICENSED PROFESSIONAL SURVEYOR

Signed by James H Granger Date November 2, 1998 Surveyor's Michigan
License No. 16041

FORM APPROVED BY MICHIGAN STATE BOARD OF PROFESSIONAL SURVEYORS, JAN. 28, 1971
REVISED 14,1975
REVISED JAN., 1983
REVISED OCT., 1996