

CHEBOYGAN COUNTY REMONUMENTATION CORNER

MAR 22 1999

LAND CORNER RECORDATION CERTIFICATE
Filing Requirement of Act 74, Mich. P.A. 1970

For corners in SECTION

<u>CHEBOYGAN</u> (County)	Located In:	Corner Code #
1. Public Land Survey	T <u>38NR 2W</u>	<u>G-7</u>
	T ___ R ___	_____
	T ___ R ___	_____
	T ___ R ___	_____
2. Property Controlling in Section	S ___ T ___ R ___	_____
	S ___ T ___ R ___	_____
3. Miscellaneous Property in Sec.	S ___ T ___ R ___	_____
	S ___ T ___ R ___	_____

RECEIVED FOR RECORD 12-7-98
at 9:20 O'Clock A. M

Joanne Spray

CLERK/REGISTER
CHEBOYGAN COUNTY, MICHIGAN

Register of Deeds Stamp & File Number

4. Lot No. _____, Recorded Plat _____
5. Private Claims _____

I, JAMES H. GRANGER, in a field survey on JULY 15, 19 98 do hereby state that under requirements of P.A. 74, Michigan P.A. of 1970, the corner points mentioned in lines 1 and 2 above were in conformance with regulations and rules therefore as required in the current manual of survey instructions of the United States Department of the Interior, Bureau of Land Management or by a decree of a Court of Law and /or that the corner points mentioned in lines 3, 4 and 5 above were in conformance with the rules of the Michigan Board of Land Surveyors or by a Decree of a Court of Law; established, re-established, monumented, recovered, found as expressed below:

NOTE: Not more than 2 corners, all in the same town and range, may be recorded on this certificate.

A. Description of original monument and accessories and/or subsequent restoration:

- 1856 Original Survey Harvey Mellen Set wood post 6" Cedar N37°E 73 lks 5" Spruce S40°W 61 lks
- 1938 County Surveyor David Bowen Fd 4" x 4" Cedar Post
- 1992 LCRC James H. Granger #16041 Set 1/2" iron with cap #16041


B. Description of corner evidence found and/or method applied in restoring or reestablishing corner:

Found 1/2" rebar with cap #16041 and 4 witnesses.

C. Description of monument for corner and accessories established to perpetuate locating the position of the corner:

- Removed 1/2" rebar and set 5/8" rebar and Remonumentation Cap
- 6" Balsam N30°W 5.15' Fd tag #16041
- 12" Cedar N86°E 12.50' Fd tag #16041
- 8" Cedar S20°E 12.49' Fd tag #16041
- 14" Cedar S32°W 16.79' Fd tag #16041

	A	B	C	D	E	F	G	H	I	J	K	L	M
1													
2	6		5		4		3		2		1		
3													
4	7		8		9		10		11		12		
5													
6	13		17		16		15		14		13		
7							●						
8	19		20		21		22		23		24		
9													
10	30		29		28		27		26		25		
11													
12	31		32		33		34		35		36		
13													

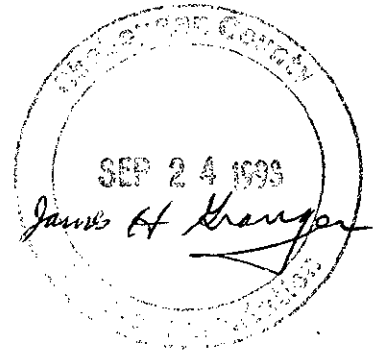

Signed by James H. Granger
License No. 16041

Date November 2, 1998

