

MAR 22 1999

CHEBOYGAN COUNTY REMONUMENTATION CORNER

LAND CORNER RECORDATION CERTIFICATE  
Filing Requirement of Act 74, Mich. P.A. 1970

For corners in SECTION

CHEBOYGAN Located In: Corner Code #  
(County)

1. Public Land Survey T 38NR 2W I-6  
T R  
T R  
T R

2. Property Controlling S T R  
in Section S T R

3. Miscellaneous S T R  
Property in Sec. S T R

RECEIVED FOR RECORD 12-7-98  
of 9:23 O'Clock A M

*Joanne Spray*

CLERK/REGISTER  
CHEBOYGAN COUNTY, MICHIGAN

Register of Deeds Stamp & File Number

4. Lot No. \_\_\_\_\_, Recorded Plat \_\_\_\_\_  
5. Private Claims \_\_\_\_\_

I, JAMES H. GRANGER, in a field survey on JULY 15, 19 98 do hereby state that under requirements of P.A. 74, Michigan P.A. of 1970, the corner points mentioned in lines 1 and 2 above were in conformance with regulations and rules therefore as required in the current manual of survey instructions of the United States Department of the Interior, Bureau of Land Management or by a decree of a Court of Law and /or that the corner points mentioned in lines 3, 4 and 5 above were in conformance with the rules of the Michigan Board of Land Surveyors or by a Decree of a Court of Law; established, re-established, monumented, recovered, found as expressed below:

NOTE: Not more than 2 corners, all in the same town and range, may be recorded on this certificate.

A. Description of original monument and accessories and/or subsequent restoration:

- 1856 Original Survey Set wood post 12" Pine N86°E 36 lks  
Harvey Mellen 6" Spruce S56°W 24 lks
- 1927 Plat Indicates corner
- 1966 Survey Concrete monument  
Orlando Doyle #7319
- 1988 LCRC Concrete monument  
James H. Granger #16041
- 1988 Survey Concrete monument  
James H. Granger #16041



	A	B	C	D	E	F	G	H	I	J	K	L	M
1													
2	6		5		4		3		2		1		
3													
4	7		8		9		10		11		12		
5													
6	18		17		16		15		14		13		
7													
8	19		20		21		22		23		24		
9													
10	30		29		28		27		26		25		
11													
12	31		32		33		34		35		36		
13													

B. Description of corner evidence found and/or method applied in restoring or reestablishing corner:

Found concrete monument and 2 witnesses. Set remonumentation cap on concrete monument

C. Description of monument for corner and accessories established to perpetuate locating the position of the corner:

- Re monumentation cap on concrete monument
- Power Pole S54°W 26.10' Fd nail and washer
- 6" Balsam S 7°W 22.18' Set tag #16041
- 16" Spruce N82°E 71.40' Fd nail and washer
- NE'y house corner S66°E 79.82'

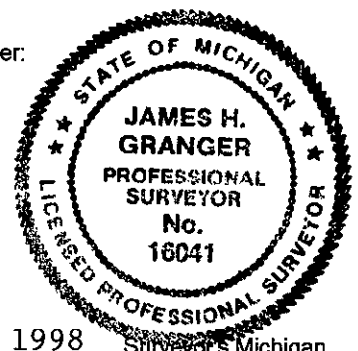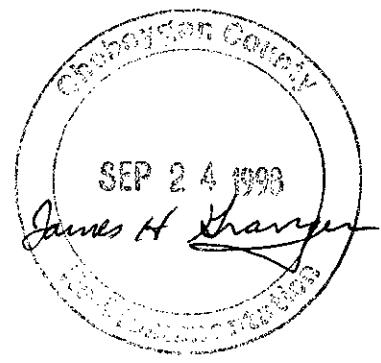

Signed by James H. Granger  
License No. 16041

Date November 2, 1998 Surveyor's Michigan