

CHEBOYGAN COUNTY REMONUMENTATION CORNER

LAND CORNER RECORDATION CERTIFICATE
Filing Requirement of Act 74, Mich. P.A. 1970

For corners in

CHEBOYGAN Located In: Corner Code #
(County)

1. Public Land Survey 38N 2W J-13
T 37NR 2W J-1
T R
T R
T R

2. Property Controlling in Section S T R
S T R

3. Miscellaneous Property in Sec. S T R
S T R

RECEIVED FOR RECORD 12-18-97
at 11:39 O'Clock A M
James Spray
CLERK/REGISTER
CHEBOYGAN COUNTY, MICHIGAN
Register of Deeds Stamp & File Number

4. Lot No. _____, Recorded Plat _____
5. Private Claims _____

I, JAMES H. GRANGER, in a field survey on JULY 15, 19 97 do hereby state that under requirements of P.A. 74, Michigan P.A. of 1970, the corner points mentioned in lines 1 and 2 above were in conformance with regulations and rules therefore as required in the current manual of survey instructions of the United States Department of the Interior, Bureau of Land Management or by a decree of a Court of Law and /or that the corner points mentioned in lines 3, 4 and 5 above were in conformance with the rules of the Michigan Board of Land Surveyors or by a Decree of a Court of Law; established, re-established, monumented, recovered, found as expressed below:

NOTE: Not more than 2 corners, all in the same town and range, may be recorded on this certificate.

A. Description of original monument and accessories and/or subsequent restoration:

- J-1 1840 Original Survey John Mullett 14" Fir at corner
- 1963 LCRC Kenneth Larsen #10695 1/2" pipe

SURVEY & REMONUMENTATION
FEB 26 1998
SECTION

1	A	B	C	D	E	F	G	H	I	J	K	L	M
2		6		5		4		3		2		1	
3													
4		7		8		9		10		11		12	
5													
6		18		17		16		15		14		13	
7													
8		19		20		21		22		23		24	
9													
10		30		29		28		27		26		25	
11													
12		31		32		33		34		35		36	
13													



B. Description of corner evidence found and/or method applied in restoring or reestablishing corner:


- J-1 Found 1/2" pipe and 2 witnesses from 1963 LCRC. Replaced with 5/8" rebar and remonumentation cap in Monument Box.

C. Description of monument for corner and accessories established to perpetuate locating the position of the corner:

- J-1 5/8" rebar and Remonumentation Cap in Monument Box
- SW corner of house N35°W 99.95' Fd nail and washer
- PP N12°E 31.00' Fd nail and washer
- PP N65°W 103.18' Set tag #16041
- 5" Birch S15°W 34.66' Set tag #16041

Signed by James H. Granger
License No. 16041

Date Nov 17, 1997 Surveyor's Michigan

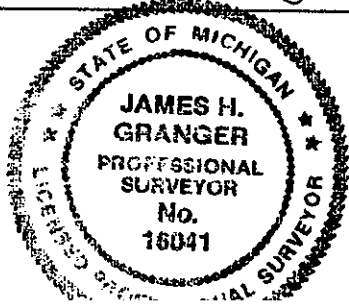

FORM APPROVED BY MICHIGAN STATE BOARD OF PROFESSIONAL SURVEYORS, JAN. 28, 1971
REVISED 14, 1976

REVISED JAN. 1983
REVISED OCT., 1986