

**SURVEY &
REMONUMENTATION**

MAY 03 1995

CHEBOYGAN COUNTY REMONUMENTATION

**LAND CORNER RECORDATION CERTIFICATE
COMMISSION**

Filing Requirement of Act 74, Mich. P.A. 1970

RECEIVED
FOR RECORD

94 NOV 22 AM 9:47

James Sperry
CLERK/REGISTER
CHEBOYGAN COUNTY, MICHIGAN

For corners in

<u>Cheboygan</u> (County)	Located In:	Corner Code =#
1. Public Land Survey	T <u>38N</u> R <u>2W</u>	<u>K-9</u>
	T _____ R _____	_____
	T _____ R _____	_____
	T _____ R _____	_____
2. Property Controlling in Section	S _____ T _____ R _____	_____
	S _____ T _____ R _____	_____
3. Miscellaneous Property in Sec.	S _____ T _____ R _____	_____
	S _____ T _____ R _____	_____

Register of Deeds Stamp & File Number

4. Lot No. _____, Recorded Plat _____
5. Private Claims _____

	A	B	C	D	E	F	G	H	I	J	K	L	M
2	6	5	4	3	2	1							
3													
4	7	8	9	10	11	12							
5													
6	18	17	16	15	14	13							
7													
8	19	20	21	22	23	24							
9													
10	30	29	28	27	26	25							
11													
12	31	32	33	34	35	36							
13													

I, James H. Granger, in a field survey on August 15, 19 94, do hereby certify that under requirements of P.A. 74, Michigan P.A. of 1970, the corner points mentioned in lines 1 and 2 above were in conformance with regulations and rules therefore as required in the current manual of survey instructions of the United States Department of the Interior, Bureau of Land Management or by a decree of a Court of Law and/or that the corner points mentioned in lines 3, 4 and 5 above were in conformance with the rules of the Michigan Board of Land Surveyors or by a Decree of a Court of Law; established, re-established, monumented, re-monumented, recovered, found as expressed below:


NOTE: Not more than 4 corners, all in the same town and range, may be recorded on this certificate.

A. Description of original monument and accessories and/or subsequent restoration:

1856 Original Survey Set wood post, 7" Tamarack S 40°W 24 lks, 6" Cedar N 77°E 7 lks.
John Mullett
1953 Orlando Doyle #7319 Set 1" Pipe
1988 Marvin Ross #16051 Fd 1" Pipe

B. Description of corner evidence found and/or method applied in restoring or reestablishing corner:


Fd 1" pipe. Fd witnesses. Reset 5/8" rebar w/aluminum cap in Monument Box.

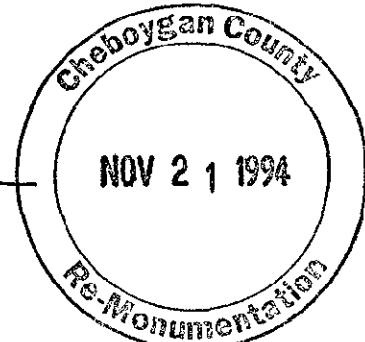

C. Description of monument for corner and accessories established to perpetuate locating the position of the corner:

5/8" rebar w/aluminum cap in Monument Box.
5" Balsam N 10°W 11.20'
8" Birch N 84°W 21.67'
8" Balsam S 78°W 15.03'
60" Willow Clump S 17°W 29.52'

LIBER 010 PAGE 52

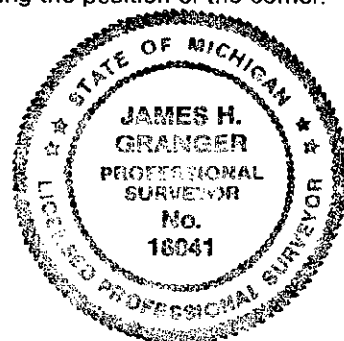

Witnessed by James H. Granger

Date 11-18-94

Surveyor's Michigan License No. 16041