

**SURVEY & REMONUMENTATION**

**MAY 03 1995 CHEBOYGAN COUNTY REMONUMENTATION  
LAND CORNER RECORDATION CERTIFICATE**

RECEIVED FOR RECORD

94 NOV 22 AM 10:16

COMMISSION Filing Requirement of Act 74, Mich. P.A. 1970

*James H. Granger*  
CLERK/REGISTER  
CHEBOYGAN COUNTY, MICHIGAN

Register of Deeds Stamp & File Number

For corners in <u>Cheboygan</u> (County)	Located In:	Corner Code #
1. Public Land Survey	T <u>38N</u> R <u>2W</u>	<u>K-10</u>
	T _____ R _____	_____
	T _____ R _____	_____
	T _____ R _____	_____
2. Property Controlling in Section	S _____ T _____ R _____	_____
	S _____ T _____ R _____	_____
3. Miscellaneous Property in Sec.	S _____ T _____ R _____	_____
	S _____ T _____ R _____	_____

4. Lot No. \_\_\_\_\_, Recorded Plat \_\_\_\_\_  
5. Private Claims \_\_\_\_\_

	A	B	C	D	E	F	G	H	I	J	K	L	M
2	6		5		4		3		2		1		
3													
4	7		8		9		10		11		12		
5													
6	18		17		16		15		14		13		
7													
8	19		20		21		22		23		24		
9													
10	30		29		28		27		26		25		
11													
12	31		32		33		34		35		36		
13													


I, James H. Granger, in a field survey on August 15, 19 94, do hereby certify that under requirements of P.A. 74, Michigan P.A. of 1970, the corner points mentioned in lines 1 and 2 above were in conformance with regulations and rules therefore as required in the current manual of survey instructions of the United States Department of the Interior, Bureau of Land Management or by a decree of a Court of Law and/or that the corner points mentioned in lines 3, 4 and 5 above were in conformance with the rules of the Michigan Board of Land Surveyors or by a Decree of a Court of Law; established, re-established, monumented, re-monumented, recovered, found as expressed below:

**NOTE: Not more than 4 corners, all in the same town and range, may be recorded on this certificate.**

A. Description of original monument and accessories and/or subsequent restoration:


- 1856 Original Survey Set wood post 16" Cedar N57°W 17 lks, 9" Cedar N9°E, 7 lks John Mullett
- 1976 Orlando Doyle #7319 Fd pipe
- 1993 Delmer Porter #15410 Fd pipe and replaced with 1/2" rod w/cap #15410

B. Description of corner evidence found and/or method applied in restoring or reestablishing corner:  
Found 1/2" rod w/cap #15410. Replaced with 5/8" rebar w/ aluminum cap. Found 4 witnesses.

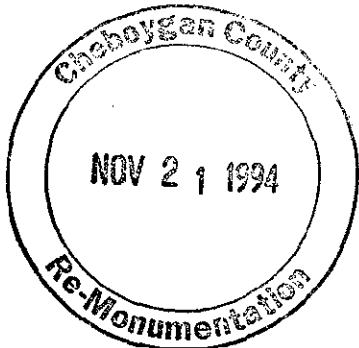*James H. Granger*  


Description of monument for corner and accessories established to perpetuate locating the position of the corner:

- 5/8" rebar w/aluminum cap in Monument Box
- Gatepost S84°W 30.95'
- Gatepost N79°W 33.31'
- 36" Willow N28°W 65.25'
- 5" Willow N39°E 54.31'

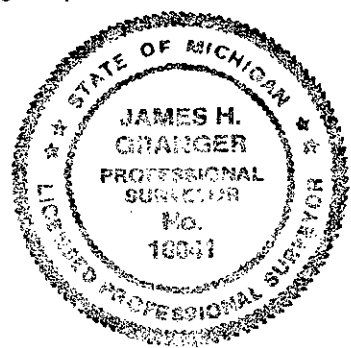

LIBER 010 PAGE 66

Signed by James H. Granger Date 11-18-94  
Surveyor's Michigan License No. 16041