

Blaugher SURVEY & REMONUMENTATION

RECEIVED FOR RECORD

CHEBOYGAN COUNTY REMONUMENTATION LAND CORNER RECORDATION CERTIFICATE

94 NOV 22 AM 9:58

MAY 03 1995 Filing Requirement of Act 74, Mich. P.A. 1970

For corners in

Cheboygan

(County)

COMMISSION

Corner Code #

- | | | |
|------------------------------------|--------------------------|-------------|
| 1. Public Land Survey | T <u>38N</u> R <u>2W</u> | <u>K-11</u> |
| | T _____ R _____ | _____ |
| | T _____ R _____ | _____ |
| | T _____ R _____ | _____ |
| 2. Property Controlling in Section | S _____ T _____ R _____ | _____ |
| | S _____ T _____ R _____ | _____ |
| 3. Miscellaneous Property in Sec. | S _____ T _____ R _____ | _____ |
| | S _____ T _____ R _____ | _____ |

James Spray
CLERK/REGISTER
CHEBOYGAN COUNTY, MICHIGAN

Register of Deeds Stamp & File Number

4. Lot No. _____, Recorded Plat _____
5. Private Claims _____

A	B	C	D	E	F	G	H	I	J	K	L	M
2	6	5	4	3	2	1						
3												
4	7	8	9	10	11	12						
5												
6	18	17	16	15	14	13						
7												
8	19	20	21	22	23	24						
9												
10	30	29	28	27	26	25						
11												
12	31	32	33	34	35	36						
13												

I, James H. Granger, in a field survey on August 15, 1994, do hereby certify that under requirements of P.A. 74, Michigan P.A. of 1970, the corner points mentioned in lines 1 and 2 above were in conformance with regulations and rules therefore as required in the current manual of survey instructions of the United States Department of the Interior, Bureau of Land Management or by a decree of a Court of Law and/or that the corner points mentioned in lines 3, 4 and 5 above were in conformance with the rules of the Michigan Board of Land Surveyors or by a Decree of a Court of Law; established, re-established, monumented, re-monumented, recovered, found as expressed below:

NOTE: Not more than 4 corners, all in the same town and range, may be recorded on this certificate.

A. Description of original monument and accessories and/or subsequent restoration:


1856 Original Survey Set wood post 8" Cedar S52°E 16 lks, 6" Cedar N67°W 24 lks. John Mullett

- 1957 Orlando Doyle #7319 Fd 1" pipe
- 1975 Orlando Doyle #7319 Fd 1" pipe
- 1990 James H. Granger #16041 Fd 1" Bolt

B. Description of corner evidence found and/or method applied in restoring or reestablishing corner:

Fd 1" rod with squared head. Found 3 witnesses and placed a 4th witness. Reset 5/8" rebar w/aluminum cap in Monument Box


Marcus A. Ross

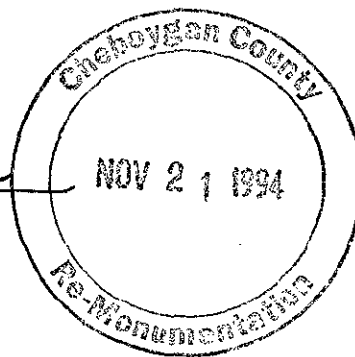

Description of monument for corner and accessories established to perpetuate locating the position of the corner:

- PP N42°W 54.12' 5/8" rebar w/ aluminum cap in Monument Box
- PP S49°W 56.19'
- Cottonwood clump S36°W 27.40'
- 1/2" Rebar N48°E 65.46'

LIBER 010 PAGE 56

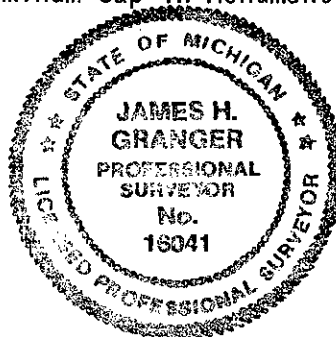

Signed by James H. Granger

Date 11-18-94

Surveyor's Michigan License No. 16041