

SURVEY & REMONUMENTATION

MAY 03 1995

COMMISSION

CHEBOYGAN COUNTY REMONUMENTATION
LAND CORNER RECORDATION CERTIFICATE
Filing Requirement of Act 74, Mich. P.A. 1970

RECEIVED FOR RECORD

94 NOV 22 AM 10:15

James Gray
CLERK/REGISTER
CHEBOYGAN COUNTY, MICHIGAN

For corners in

Cheboygan
(County)

Located In:

Corner Code #

1. Public Land Survey	T	<u>38N</u>	R	<u>2W</u>	<u>K-13</u>
	T	_____	R	_____	_____
	T	_____	R	_____	_____
	T	_____	R	_____	_____
2. Property Controlling in Section	S	_____	T	_____	R
	S	_____	T	_____	R
3. Miscellaneous Property in Sec.	S	_____	T	_____	R
	S	_____	T	_____	R

Register of Deeds Stamp & File Number

4. Lot No. _____, Recorded Plat _____
5. Private Claims _____

A	B	C	D	E	F	G	H	I	J	K	L	M
2	6	5	4	3	2	1						
3												
4	7	8	9	10	11	12						
5												
6	18	17	16	15	14	13						
7												
8	19	20	21	22	23	24						
9												
10	30	29	28	27	26	25						
11												
12	31	32	33	34	35	36						
13												

I, James H. Granger, in a field survey on August 15, 19 94, do hereby certify that under requirements of P.A. 74, Michigan P.A. of 1970, the corner points mentioned in lines 1 and 2 above were in conformance with regulations and rules therefore as required in the current manual of survey instructions of the United States Department of the Interior, Bureau of Land Management or by a decree of a Court of Law and/or that the corner points mentioned in lines 3, 4 and 5 above were in conformance with the rules of the Michigan Board of Land Surveyors or by a Decree of a Court of Law; established, re-established, monumented, re-monumented, recovered, found as expressed below:

NOTE: Not more than 4 corners, all in the same town and range, may be recorded on this certificate.


A. Description of original monument and accessories and/or subsequent restoration:

1840 Original Survey Set wood post, 12" B. Ash N12°W, 15 lks, 8" B. Ash N59°E, 35 lks John Mullett

1958 Subdivision Dean DeLameter #05778 Plat Monument
1977 John Nelson #21273 Fd 1/2" rod
1994 James Granger #16041 Fd 1/2" rod

B. Description of corner evidence found and/or method applied in restoring or reestablishing corner:

Fd 1/2" rod and 2 witnesses. Reset 5/8" rebar w/ aluminum cap in Monument Box.

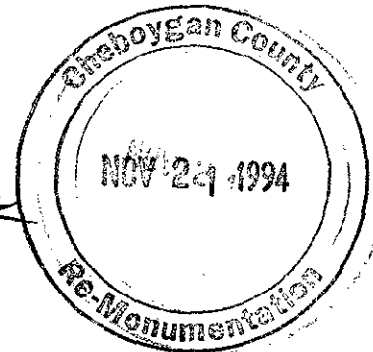


Manuel A. Ross

C. Description of monument for corner and accessories established to perpetuate locating the position of the corner:

5/8" rebar w/aluminum cap in Monument Box

PP	N 6°E	52.18'
PP	S 15°E	95.53
6" Spruce Post	S 20°W	116.38'
	S 87°W	158.78'

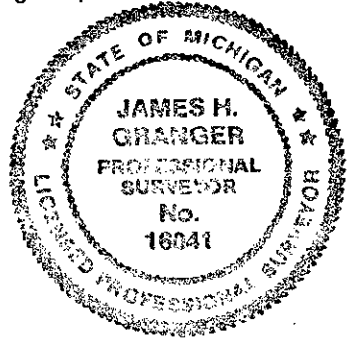

LIBER 010 PAGE 65

Signed by James H. Granger
Surveyor's Michigan License No. 16041

Date 11-18-99