

**SURVEY & REMONUMENTATION**

**CHEBOYGAN COUNTY REMONUMENTATION**

MAY 03 1995

**LAND CORNER RECORDATION CERTIFICATE**

Filing Requirement of Act 74, Mich. P.A. 1970

**COMMISSION**

RECEIVED FOR RECORD

94 NOV 22 AM 10:04

*James H. Granger*  
CLERK/REGISTER  
CHEBOYGAN COUNTY, MICHIGAN

Register of Deeds Stamp & File Number

For corners in

Cheboygan  
(County)

Located In:

Corner Code #/

1. Public Land Survey	T <u>38N</u> R <u>2W</u>	<u>L-11</u>
	T _____ R _____	_____
	T _____ R _____	_____
	T _____ R _____	_____
2. Property Controlling in Section	S _____ T _____ R _____	_____
	S _____ T _____ R _____	_____
3. Miscellaneous Property in Sec.	S _____ T _____ R _____	_____
	S _____ T _____ R _____	_____

4. Lot No. \_\_\_\_\_, Recorded Plat \_\_\_\_\_

5. Private Claims \_\_\_\_\_

	A	B	C	D	E	F	G	H	I	J	K	L	M
2	6	5	4	3	2	1							
3													
4	7	8	9	10	11	12							
5													
6	18	17	16	15	14	13							
7													
8	19	20	21	22	23	24							
9													
10	30	29	28	27	26	25							
11													
12	31	32	33	34	35	36							
13													

I, James H. Granger, in a field survey on August 15, 19 94, do hereby certify that under requirements of P.A. 74, Michigan P.A. of 1970, the corner points mentioned in lines 1 and 2 above were in conformance with regulations and rules therefore as required in the current manual of survey instructions of the United States Department of the Interior, Bureau of Land Management or by a decree of a Court of Law and/or that the corner points mentioned in lines 3, 4 and 5 above were in conformance with the rules of the Michigan Board of Land Surveyors or by a Decree of a Court of Law; established, re-established, monumented, re-monumented, recovered, found as expressed below:

**NOTE: Not more than 4 corners, all in the same town and range, may be recorded on this certificate.**


A. Description of original monument and accessories and/or subsequent restoration:

- 1856 Original Survey Set wood post, 10" B. Ash N19°W 15 lks, 12" Spruce S74°E 4 lks Harvey Mellen
- 1892 O.D. Hayden Plat Monument
- 1963 Ken Larsen #10695 Fd 5/8" rod
- 1993 Delmer Porter #15410 Set Pk Nail

B. Description of corner evidence found and/or method applied in restoring or reestablishing corner:


Fd Pk from Porter survey. Removed Pk dug down ± 2.5' and found 1½ pipe with bolt inside. Pipe was 0.58' Easterly of Pk location. Raised with 5/8" rebar w/aluminum cap in monument box distances fit very well with Doyle Section work.

*Maurice O. Ross*

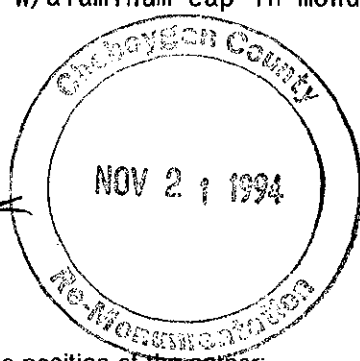

C. Description of monument for corner and accessories established to perpetuate locating the position of the corner:

- 5/8" rebar w/aluminum cap in Monument Box
- Fence Corner N43°W 100.40'
- PP N65°E 73.98'
- "X" in NE Corner
- Headwall S56°W 41.67'
- 4" Poplar S41°E 82.78'

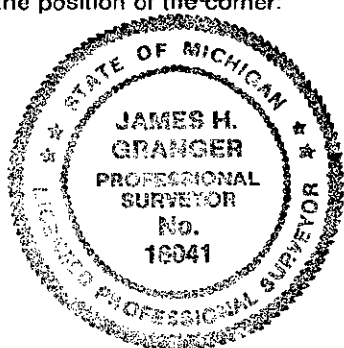

LIBER 010 PAGE 62

Signed by James H. Granger

Date 11-18-94

Surveyor's Michigan License No. 16041