

**SURVEY &
REMONUMENTATION**

CHEBOYGAN COUNTY REMONUMENTATION

Beaumont
MAY 03 1995

LAND CORNER RECORDATION CERTIFICATE

Filing Requirement of Act 74, Mich. P.A. 1970

For corners in

COMMISSION

Cheboygan
(County)

Located In:

Corner Code ##

1. Public Land Survey	T	<u>38N</u>	R	<u>2W</u>	<u>M-9</u>
	T	_____	R	_____	_____
	T	_____	R	_____	_____
	T	_____	R	_____	_____
2. Property Controlling in Section	S	_____	T	_____	R
	S	_____	T	_____	R
3. Miscellaneous Property in Sec.	S	_____	T	_____	R
	S	_____	T	_____	R

RECEIVED
FOR RECORD

94 NOV 22 AM 9:38

James Spray
CLERK/REGISTER
CHEBOYGAN COUNTY, MICHIGAN

Register of Deeds Stamp & File Number

4. Lot No. _____, Recorded Plat _____
5. Private Claims _____

	A	B	C	D	E	F	G	H	I	J	K	L	M
2	6	5	4	3	2	1							
3													
4	7	8	9	10	11	12							
5													
6	18	17	16	15	14	13							
7													
8	19	20	21	22	23	24							
9													
10	30	29	28	27	26	25							
11													
12	31	32	33	34	35	36							
13													

I, James H. Granger in a field survey on August 15, 1994, do hereby certify that under requirements of P.A. 74, Michigan P.A. of 1970, the corner points mentioned in lines 1 and 2 above were in conformance with regulations and rules therefore as required in the current manual of survey instructions of the United States Department of the Interior, Bureau of Land Management or by a decree of a Court of Law and/or that the corner points mentioned in lines 3, 4 and 5 above were in conformance with the rules of the Michigan Board of Land Surveyors or by a Decree of a Court of Law; established, re-established, monumented, re-monumented, recovered, found as expressed below:

NOTE: Not more than 4 corners, all in the same town and range, may be recorded on this certificate.

A. Description of original monument and accessories and/or subsequent restoration:

1840 Original Survey Set wood post, 12" Spruce S71°W 11 lks, 10" Tamarack N32°E 18 lks, John Mullett


1949 Orlando Doyle # 7319 Fd 1" Axle
1972 Orlando Doyle # 7319 Fd 1" Axle

B. Description of corner evidence found and/or method applied in restoring or reestablishing corner:

Fd 1" Axle with witnesses. Replaced with 5/8" Rebar w/ aluminum cap.


LIBER **010** PAGE **46**

Maurice A. Ross

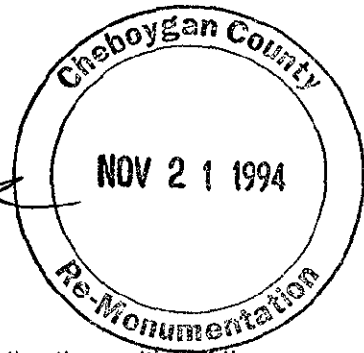

Description of monument for corner and accessories established to perpetuate locating the position of the corner:
5/8" Rebar w/aluminum cap

10" Cedar N07°E 11.61' Fd Nail w/tag
12" Cedar N63°E 7.74' Fd Nail w/tag
16" Cedar S17°W 15.74' Fd Nail w/tag
6" Cedar S68°E 10.89' Set Nail w/tag

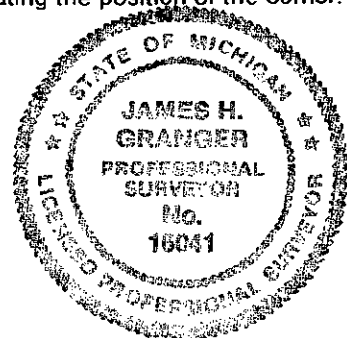

Signed by *James H. Granger*
Surveyor's Michigan License No. 16041

Date 11-10-94