

**SURVEY & REMONUMENTATION**

CHEBOYGAN COUNTY REMONUMENTATION

MAY 03 1995

**LAND CORNER RECORDATION CERTIFICATE**  
**COMMISSION Filing Requirement of Act 74, Mich. P.A. 1970**

RECEIVED FOR RECORD

94 NOV 22 AM 9:39

*James Gray*  
 CLERK/REGISTER  
 CHEBOYGAN COUNTY, MICHIGAN

For corners in

Cheboygan  
(County)

Located In:

Corner Code #

- |                                    |                          |             |
|------------------------------------|--------------------------|-------------|
| 1. Public Land Survey              | T <u>38N</u> R <u>2W</u> | <u>M-10</u> |
|                                    | T _____ R _____          | _____       |
|                                    | T _____ R _____          | _____       |
|                                    | T _____ R _____          | _____       |
| 2. Property Controlling in Section | S _____ T _____ R _____  | _____       |
|                                    | S _____ T _____ R _____  | _____       |
| 3. Miscellaneous Property in Sec.  | S _____ T _____ R _____  | _____       |
|                                    | S _____ T _____ R _____  | _____       |

Register of Deeds Stamp & File Number

4. Lot No. \_\_\_\_\_, Recorded Plat \_\_\_\_\_
5. Private Claims \_\_\_\_\_

	A	B	C	D	E	F	G	H	I	J	K	L	M
2	6	5	4	3	2	1							
3													
4	7	8	9	10	11	12							
5													
6	18	17	16	15	14	13							
7													
8	19	20	21	22	23	24							
9													
10	30	29	28	27	26	25							
11													
12	31	32	33	34	35	36							
13													

I, James H. Granger, in a field survey on August 15, 19 94, do hereby certify that under requirements of P.A. 74, Michigan P.A. of 1970, the corner points mentioned in lines 1 and 2 above were in conformance with regulations and rules therefore as required in the current manual of survey instructions of the United States Department of the Interior, Bureau of Land Management or by a decree of a Court of Law and/or that the corner points mentioned in lines 3, 4 and 5 above were in conformance with the rules of the Michigan Board of Land Surveyors or by a Decree of a Court of Law; established, re-established, monumented, re-monumented, recovered, found as expressed below:

**NOTE: Not more than 4 corners, all in the same town and range, may be recorded on this certificate.**


A. Description of original monument and accessories and/or subsequent restoration:

1840 Original Survey Set wood post 10" Fir N37°E 18 lks, 8" Fir S18°E 6 lks.  
 John Mullett

Description of corner evidence found and/or method applied in restoring or reestablishing corner:

No evidence of original corner fd. After removing ±3'x3' area of road surface placed 5/8" rebar w/aluminum cap based on surveys by Doyle Civil Engineers.


*Maurice A. Ross*

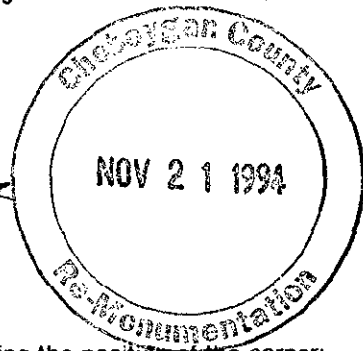

Description of monument for corner and accessories established to perpetuate locating the position of the corner:

5/8" rebar w/aluminum cap  
 PP S72°W 34.73'  
 PP N12°W 82.91'  
 PP S67°E 24.23'  
 PP S12°E 91.57'

LIBER 010 PAGE 47

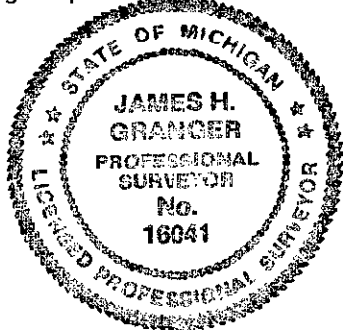

Witnessed by James H. Granger  
 Surveyor's Michigan License No. 16041

Date 11-18-94