

SURVEY & REMONUMENTATION

CHEBOYGAN COUNTY REMONUMENTATION

MAY 03 1995

LAND CORNER RECORDATION CERTIFICATE

COMMISSION

Filing Requirement of Act 74, Mich. P.A. 1970

RECEIVED FOR RECORD

94 NOV 22 AM 10:09

James H. Granger
CLERK/REGISTER
CHEBOYGAN COUNTY, MICHIGAN

For corners in

Cheboygan
(County)

Located In:

Corner Code #

- | | | | | | |
|------------------------------------|---|------------|---|-----------|-------------|
| 1. Public Land Survey | T | <u>38N</u> | R | <u>2W</u> | <u>M-11</u> |
| | T | _____ | R | _____ | _____ |
| | T | _____ | R | _____ | _____ |
| | T | _____ | R | _____ | _____ |
| 2. Property Controlling in Section | S | _____ | T | _____ | _____ |
| | S | _____ | T | _____ | _____ |
| 3. Miscellaneous Property in Sec. | S | _____ | T | _____ | _____ |
| | S | _____ | T | _____ | _____ |

Register of Deeds Stamp & File Number

4. Lot No. _____, Recorded Plat _____
5. Private Claims _____

	A	B	C	D	E	F	G	H	I	J	K	L	M
2	6	5	4	3	2	1							
3													
4	7	8	9	10	11	12							
5													
6	18	17	16	15	14	13							
7													
8	19	20	21	22	23	24							
9													
10	30	29	28	27	26	25							
11													
12	31	32	33	34	35	36							
13													

I, James H. Granger, in a field survey on August 15, 19 94, do hereby certify that under requirements of P.A. 74, Michigan P.A. of 1970, the corner points mentioned in lines 1 and 2 above were in conformance with regulations and rules therefore as required in the current manual of survey instructions of the United States Department of the Interior, Bureau of Land Management or by a decree of a Court of Law and/or that the corner points mentioned in lines 3, 4 and 5 above were in conformance with the rules of the Michigan Board of Land Surveyors or by a Decree of a Court of Law; established, re-established, monumented, re-monumented, recovered, found as expressed below:

NOTE: Not more than 4 corners, all in the same town and range, may be recorded on this certificate.


1. Description of original monument and accessories and/or subsequent restoration:

1840 Original Survey Set wood post 14" Ash N68°E 12 lks., 14" Cedar S68°W 4 lks. John Mullett

2. Description of corner evidence found and/or method applied in restoring or reestablishing corner:


Set 5/8" rebar w/ aluminum cap in monument box. Positioned corner by using monumentation from plats around section corner. Distances North and West fit very close to section work done by Doyle Civil Engineers. Distance East fit very well with GLO.

Marvin T. Ross

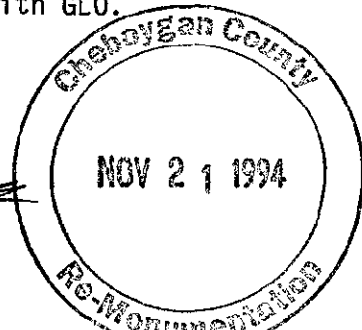

3. Description of monument for corner and accessories established to perpetuate locating the position of the corner:

5/8" Rebar w/Aluminum cap in Monument Box
 Top of Fire Hydrant S30°W 51.61'
 PP N34°W 42.37'
 PP N40°E 39.53'
 PP S10°E 74.25'

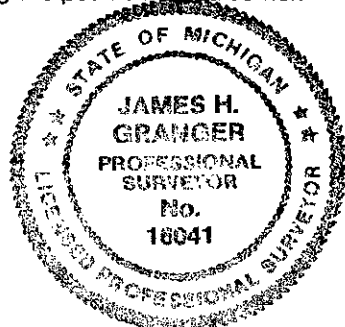

LIBER 010 PAGE 63

signed by James H. Granger
 Surveyor's Michigan License No. 16041

Date 11-18-94