

MICHIGAN
DEPARTMENT OF CONSERVATION
FORESTRY DIVISION

LAND CORNER RECORD

T. 38 N.R. 2 W


Cheboygan COUNTY

DESCRIPTION OF CORNER Sec corner common to sections 8, 9, 16, 17

CORNER MONUMENT Set 1" pipe with 1/4" aluminum cap

DATE MONUMENT PLACED AND WITNESSED July 16, 1965

WITNESSES TO CORNER.....

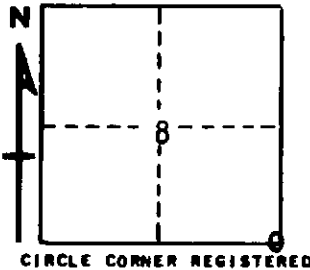

7" Balsam - N63 E - 6.9'

8" W.Birch - N 8 W - 25.4'

AND

DESCRIPTION IN DETAIL AS TO HOW CORNER WAS LOCATED AND IDENTIFIED OR RESTORED.

This corner was restored on line over good 1/4 and section corners south making 1/2 miles of equal measurement. This restoration checks the bearings east and west, and is acceptable for measurement although making the line of 9 - 16 somewhat short.

SURVEYOR'S SEAL

SIGNED Kenneth J. Ostling DATE October 19, 1965
REGISTERED LAND SURVEYOR #10068