

MICHIGAN
DEPARTMENT OF CONSERVATION
FORESTRY DIVISION

LAND CORNER RECORD

T. 38 N.R. 2 W


Cheboygan COUNTY

DESCRIPTION OF CORNER 1/4 corner common to sections 19 and 20

CORNER MONUMENT Set 1" pipe with 1/4" aluminum cap

DATE MONUMENT PLACED AND WITNESSED July 16, 1965

WITNESSES TO CORNER.....

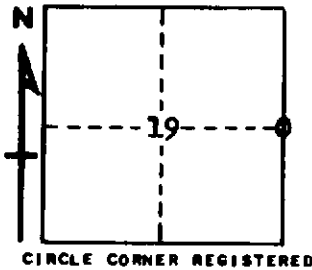

12" Cedar stp N 25 E 12.4'

20" W. Pine stp S 9 E 30.4'

AND

DESCRIPTION IN DETAIL AS TO HOW CORNER WAS LOCATED AND IDENTIFIED OR RESTORED.

This corner was set by proportionate measurement, midpoint on line, between section corners. Cannot identify U.S.B.TS.

SURVEYOR'S SEAL

SIGNED *Kenneth J. Ostling* DATE October 19, 1965
REGISTERED LAND SURVEYOR 10068