

MICHIGAN
DEPARTMENT OF CONSERVATION
FORESTRY DIVISION

LAND CORNER RECORD

T. 38 N.R. 2 W.
T. 38 N.R. 3 W.


Cheboygan COUNTY

DESCRIPTION OF CORNER Section corner common to Sections 19 - 30 - 24 - 25

CORNER MONUMENT Set 1" pipe with 4" brass cap

DATE MONUMENT PLACED AND WITNESSED May 20, 1963

WITNESSES TO CORNER.....

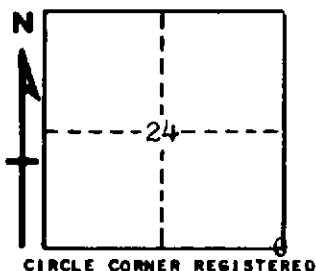

8" Cedar N 60 W 42.4'

6" W. Pine S 42 E 67.2'

AND

DESCRIPTION IN DETAIL AS TO HOW CORNER WAS LOCATED AND IDENTIFIED OR RESTORED.

This corner was set while making a retracement in this area. Unable to locate anything for a previous corner, but all available evidence and measurements to surrounding existing corners indicate this corner likely was previously established at old township grade intersection. We restored this corner in center of N - S road grade for longitude and at proportionate measurement between section corners one mile south and two miles north for latitude. This falls on north edge of present E - W grade, but fairly well between old ditch lines, and conforms to line prescribed by old corners on line of 19 - 30. Also conforms fairly well for proportionate measurement to restored corners one mile east and one mile west. Felt to be the best determination possible in view of the available evidence. Strict single proportion would create distorted sections and poor land distribution.

SURVEYOR'S SEAL

SIGNED *Lucretia J. DeLing* DATE June 24, 1963
REGISTERED LAND SURVEYOR # 10068