

MICHIGAN
DEPARTMENT OF CONSERVATION
FORESTRY DIVISION

LAND CORNER RECORD

T. 38 N.R. 2 W.
T. 38 N.R. 3 W.


Cheboygan COUNTY

DESCRIPTION OF CORNER Section corner common to Sections 18 - 19 - 13 - 24

CORNER MONUMENT Set 1" pipe with 4" brass cap

DATE MONUMENT PLACED AND WITNESSED May 20, 1963

WITNESSES TO CORNER.....

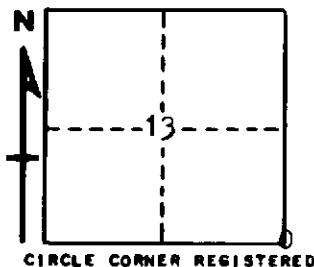

7" Cedar N 84 E 9.2'

7" Cedar S 11 E 37.5'

AND

8" Cedar S 67 W 59.5'

DESCRIPTION IN DETAIL AS TO HOW CORNER WAS LOCATED AND IDENTIFIED OR RESTORED.

This corner was set by proportionate measurement between section corners one mile north and one mile south, while making a survey in this area. Many stumps in this area but can identify nothing positive. Checks okay for measurement east and west.

SURVEYOR'S SEAL

SIGNED *Kenneth J. Osting* DATE June 24, 1963
REGISTERED LAND SURVEYOR #10968