

MICHIGAN
DEPARTMENT OF CONSERVATION
FORESTRY DIVISION

LAND CORNER RECORD

T. 38 N.R. 2 W.


Cheboygan COUNTY

DESCRIPTION OF CORNER Section corner common to Sections 5 - 6 - 7 - 8

CORNER MONUMENT Set 1" pipe with 4" brass cap

DATE MONUMENT PLACED AND WITNESSED May 22, 1963

WITNESSES TO CORNER.....

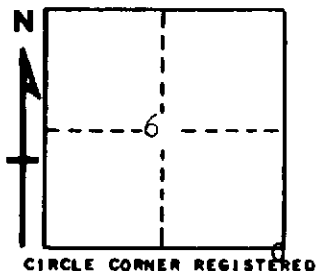

5" Spruce S 18 E 35.2'

6" Spruce S 85 W 39.4'

AND

6" Ash N 26 W 19.4'

DESCRIPTION IN DETAIL AS TO HOW CORNER WAS LOCATED AND IDENTIFIED OR RESTORED.

This corner was found while making a survey in this area. Found 1" axle and very old post which we take to be Bowen's corner. A cedar longbutt with probable evidence of both faces for NE U. S. BT and a cedar stump for SW BT. Bearings okay but distances would put corner about two feet east of axle, but set corner at 1" iron bar, presuming the original post was recovered in Bowen's survey. Could find nothing with more support so considered this corner acceptable.

SURVEYOR'S SEAL

SIGNED *Kenneth J. Ostling* DATE June 25, 1963
REGISTERED LAND SURVEYOR