

MICHIGAN
DEPARTMENT OF CONSERVATION
FORESTRY DIVISION

LAND CORNER RECORD


T. 38 N.R. 2 W.
T. 38 N.R. 3 W.
Cheboygan COUNTY

DESCRIPTION OF CORNER Section corner common to Sections 6 - 7 - 1 - 12

CORNER MONUMENT Set 1" pipe with 4" brass cap

DATE MONUMENT PLACED AND WITNESSED April 18, 1963

WITNESSES TO CORNER.....

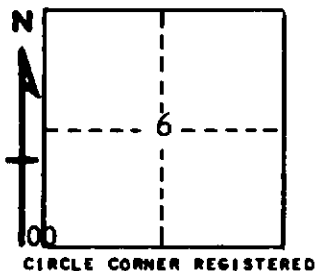

7" Cedar N 41 W 21.9'
8" Cedar N 72 E 49.9'
AND
5" Ash S 66 W 31.4

DESCRIPTION IN DETAIL AS TO HOW CORNER WAS LOCATED AND IDENTIFIED OR RESTORED.

This corner was found while making a survey in this area. Found very old 6" square post and 4" square concrete monument at corner, probably by Bowen. Found remains of U. S. corner tree with evidence of face, down, but still identifiable. Other USBTs gone.

SURVEYOR'S SEAL

SIGNED Kenneth Ostling DATE April 24, 1963
REGISTERED LAND SURVEYOR #10068