

SURVEY & REMONUMENTATION CHEBOYGAN COUNTY REMONUMENTATION CORNER

MAY 05 1997

LAND CORNER RECORDATION CERTIFICATE
Filing Requirement of Act 74, Mich. P.A. 1970

For corners in CHEBOYGAN COMMISSION

Located In: Corner Code #

- 1. Public Land Survey T 38N R 3W M-1
T _____ R _____
T _____ R _____
T _____ R _____
- 2. Property Controlling S _____ T _____ R _____
in Section S _____ T _____ R _____
- 3. Miscellaneous S _____ T _____ R _____
Property in Sec. S _____ T _____ R _____

RECEIVED FOR RECORD
96 OCT 30 PM 12:03
James H. Granger
CLERK/REGISTER
CHEBOYGAN COUNTY, MICHIGAN
Register of Deeds Stamp & File Number

4. Lot No. _____, Recorded Plat _____

5. Private Claims _____

I, JAMES H. GRANGER, in a field survey on SEPTEMBER 24, 19 96 do hereby state that under requirements of P.A. 74, Michigan P.A. of 1970, the corner points mentioned in lines 1 and 2 above were in conformance with regulations and rules therefore as required in the current manual of survey instructions of the United States Department of the Interior, Bureau of Land Management or by a decree of a Court of Law and /or that the corner points mentioned in lines 3, 4 and 5 above were in conformance with the rules of the Michigan Board of Land Surveyors or by a Decree of a Court of Law; established, re-established, monumented, recovered, found as expressed below:


1	A	B	C	D	E	F	G	H	I	J	K	L	M
2		6		5		4		3		2		1	
3													
4		7		8		9		10		11		12	
5													
6		18		17		16		15		14		13	
7													
8		19		20		21		22		23		24	
9													
10		30		29		28		27		26		25	
11													
12		31		32		33		34		35		36	
13													

NOTE: Not more than 2 corners, all in the same town and range, may be recorded on this certificate.

A. Description of original monument and accessories and/or subsequent restoration:

- 1840 Original Survey John Mullett Set wood post 12" Fir S40°W 12 lks
10" Tamarack N69°E 15 lks
- 1967 Survey Orlando Doyle # 7319 Metal Monument
- 1992 LCRC James H. Granger # 16041 Set PK Nail

Martin A. Rees

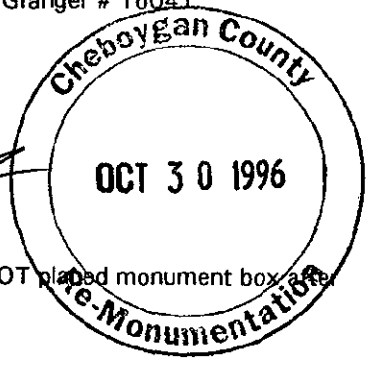

B. Description of corner evidence found and/or method applied in restoring or reestablishing corner:


Found PK nail and four witnesses. PK nail subsequently removed by MDOT repaving project. MDOT placed monument box and repaving at position from witnesses.

LIBER 010 PAGE 168

C. Description of monument for corner and accessories established to perpetuate locating the position of the corner, also corner A-1, T38N, R2W

Set 5/8" x 30" rebar with Remonumentation Cap inside monument box

- 9" Spruce S05°W 75.36' Fd tag
- 12" Balsam S70°W 77.10' Fd tag
- Conc. Mon. N08°E 79.56'
- Satellite Dish N55°E 85.00'
- Ceneterline US-23 S33°W 3.3'

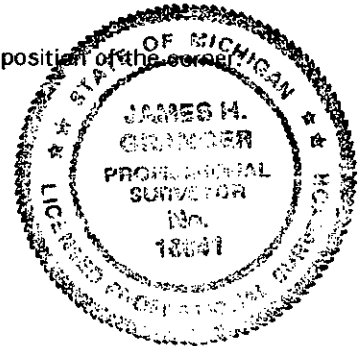

Signed by *James H. Granger*
Surveyor's Michigan License No. 16041

Date 10-10-96