

**CHEBOYGAN COUNTY REMONUMENTATION CORNER**  
**SURVEY & LAND CORNER RECORDATION CERTIFICATE**  
**REMONUMENTATION Filing Requirement of Act 74, Mich. P.A. 1970**

For corners in  
CHEBOYGAN

MAY 05 1997

Located In: \_\_\_\_\_ Corner Code # \_\_\_\_\_

(County) **COMMISSION**

- |                                    |                          |            |
|------------------------------------|--------------------------|------------|
| 1. Public Land Survey              | T <u>38N</u> R <u>3W</u> | <u>M-2</u> |
|                                    | T _____ R _____          | _____      |
|                                    | T _____ R _____          | _____      |
|                                    | T _____ R _____          | _____      |
| 2. Property Controlling in Section | S _____ T _____ R _____  | _____      |
|                                    | S _____ T _____ R _____  | _____      |
| 3. Miscellaneous Property in Sec.  | S _____ T _____ R _____  | _____      |
|                                    | S _____ T _____ R _____  | _____      |

RECEIVED  
FOR RECORD  
96 OCT 30 PM 12:07  
*Joanna Spray*  
CLERK/REGISTER  
CHEBOYGAN COUNTY, MICHIGAN  
Register of Deeds Stamp & File Number

4. Lot No. \_\_\_\_\_, Recorded Plat \_\_\_\_\_

5. Private Claims \_\_\_\_\_

	A	B	C	D	E	F	G	H	I	J	K	L	M
1													
2	6		5		4		3		2		1		
3													
4	7		8		9		10		11		12		
5													
6	18		17		16		15		14		13		
7													
8	19		20		21		22		23		24		
9													
10	30		29		28		27		26		25		
11													
12	31		32		33		34		35		36		
13													

I, JAMES H. GRANGER, in a field survey on SEPTEMBER 24, 19 96 do hereby state that under requirements of P.A. 74, Michigan P.A. of 1970, the corner points mentioned in lines 1 and 2 above were in conformance with regulations and rules therefore as required in the current manual of survey instructions of the United States Department of the Interior, Bureau of Land Management or by a decree of a Court of Law and/or that the corner points mentioned in lines 3, 4 and 5 above were in conformance with the rules of the Michigan Board of Land Surveyors or by a Decree of a Court of Law; established, re-established, monumented, recovered, found as expressed below:

**NOTE: Not more than 2 corners, all in the same town and range, may be recorded on this certificate.**


**A. Description of original monument and accessories and/or subsequent restoration:**

- |                                      |  |
|--------------------------------------|--|
| 1840 Original Survey<br>John Mullett | Set wood post 10" Cedar N65°E 6 lks<br>8" Fir SO4°W 14 lks |
| 1981 Survey<br>Orlando Doyle # 7319  | Metal Monument   |
| 1985 Survey<br>Orlando Doyle # 7319  | 1" pipe  |

**B. Description of corner evidence found and/or method applied in restoring or reestablishing corner:**

Found 1" pipe in concrete monument.

*Martin Ross*

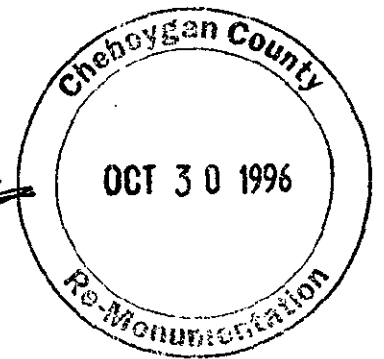


LIBER **010** PAGE **169**

**C. Description of monument for corner and accessories established to perpetuate locating the position of the corner:**

**also corner A-2, T38N, R2W**

Set 5/8" x 30" rebar inside 1" pipe with Remonumentation Cap

- |            |       |        |                |
|------------|-------|--------|----------------|
| 1" Pipe    |       |        |                |
| 14' Spruce | N30°W | 15.60' | Set nail w/tag |
| 12" Poplar | S57°W | 6.99'  | Set nail w/tag |
| 8" Balsam  | S21°E | 22.35' | Set nail w/tag |
| 8" Balsam  | S62°E | 23.82' | Set nail w/tag |

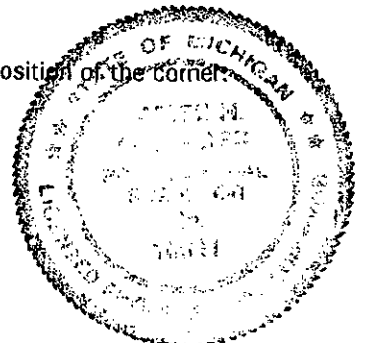

Signed by James H. Granger  
Surveyor's Michigan License No. 16041

Date 10-10-96