

MAY 05 1997

CHEBOYGAN COUNTY REMONUMENTATION CORNER
LAND CORNER RECORDATION CERTIFICATE
Filing Requirement of Act 74, Mich. P.A. 1970

For corners in
CHEBOYGAN

Located In: Corner Code #

(County)

- | | | | |
|---------------------------------------|---------|--------------------------|------------|
| 1. Public Land Survey | | T <u>38N</u> R <u>3W</u> | <u>M-4</u> |
| | | T _____ R _____ | _____ |
| | | T _____ R _____ | _____ |
| | | T _____ R _____ | _____ |
| 2. Property Controlling
in Section | S _____ | T _____ R _____ | _____ |
| | S _____ | T _____ R _____ | _____ |
| 3. Miscellaneous
Property in Sec. | S _____ | T _____ R _____ | _____ |
| | S _____ | T _____ R _____ | _____ |

RECEIVED
FOR RECORD
96 OCT 30 PM 12:09
James H. Granger
CLERK/REGISTER
CHEBOYGAN COUNTY, MICHIGAN
Register of Deeds Stamp & File Number

4. Lot No. _____, Recorded Plat _____

5. Private Claims _____

I, JAMES H. GRANGER, in a field survey on OCTOBER 18, 19 96
do hereby state that under requirements of P.A. 74, Michigan P.A. of 1970, the corner points
mentioned in lines 1 and 2 above were in conformance with regulations and rules therefore as
required in the current manual of survey instructions of the United States Department of the Interior,
Bureau of Land Management or by a decree of a Court of Law and for that the corner points
mentioned in lines 3, 4 and 5 above were in conformance with the rules of the Michigan Board of
Land Surveyors or by a Decree of a Court of Law; established, re-established, monumented,
recovered, found as expressed below:

NOTE: Not more than 2 corners, all in the same town and range, may be recorded
on this certificate.

	A	B	C	D	E	F	G	H	I	J	K	L	M
1													
2		6		5		4		3		2		1	
3													
4		7		8		9		10		11		12	
5													
6		18		17		16		15		14		13	
7													
8		19		20		21		22		23		24	
9													
10		30		29		28		27		26		25	
11													
12		31		32		33		34		35		36	
13													


A. Description of original monument and accessories and/or subsequent restoration:

- | | | | |
|--|----------------------------|---------------------------------------|------------------|
| 1840 - Original Survey
John Mullett | Set wood post | 14" Hemlock S25°W
8" Hemlock N16°E | 10 lks
18 lks |
| 1964 - DNR-LCRC
Ken Larsen #10695 | Set 1" pipe w/4" brass cap | | |
| 1972 - Survey
Orlando Doyle #7319 | Fd 1" pipe w/brass cap | | |
| 1973 - LCRC
Orlando Doyle #7319 | Fd 1" pipe w/brass cap | | |

B. Description of corner evidence found and/or method applied in restoring or reestablishing corner:

Found 1" pipe with 4" brass cap, one scribed witness and set four witnesses.

Marvin A. Paul

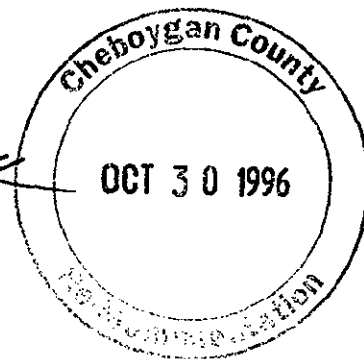


LIBER 010 PAGE 171

C. Description of monument for corner and accessories established to perpetuate locating the position of the corner

also corner A-4, T38N, R2W

1" pipe

- | | | |
|--------------|--------|--------|
| 8" Tri Maple | N 72°E | 13.04' |
| 14" Poplar | N22°W | 4.69' |
| 6" Maple | N46°W | 17.09' |
| 12" Maple | S34°W | 13.53' |

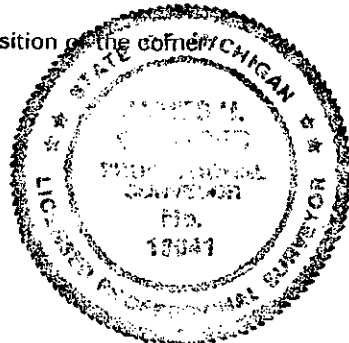

Signed by James H. Granger

Date 10-18-96

Surveyor's Michigan License No. 16041