

SURVEY & REMONUMENTATION - CHEBOYGAN COUNTY REMONUMENTATION CORNER

MAY 05 1997

**LAND CORNER RECORDATION CERTIFICATE
Filing Requirement of Act 74, Mich. P.A. 1970**

corners in CHEBOYGAN COMMISSION

Located In: Corner Code #

(County)

Public Land Survey T 38N R 3W Corner Code # M-5
 T _____ R _____
 T _____ R _____
 T _____ R _____
 Property Controlling S _____ T _____ R _____
 in Section S _____ T _____ R _____
 Miscellaneous S _____ T _____ R _____
 Property in Sec. S _____ T _____ R _____

RECEIVED FOR RECORD

96 OCT 30 PM 12:12

James H. Granger

CLERK/REGISTER CHEBOYGAN COUNTY, MICHIGAN

Register of Deeds Stamp & File Number

Lot No. _____, Recorded Plat _____

Private Claims _____

	A	B	C	D	E	F	G	H	I	J	K	L	M
1													
2	6		5		4		3		2		1		
3													
4	7		8		9		10		11		12		
5													
6	18		17		16		15		14		13		
7													
8	19		20		21		22		23		24		
9													
10	30		29		28		27		26		25		
11													
12	31		32		33		34		35		36		
13													

JAMES H. GRANGER, in a field survey on SEPTEMBER 24, 1996 hereby state that under requirements of P.A. 74, Michigan P.A. of 1970, the corner points mentioned in lines 1 and 2 above were in conformance with regulations and rules therefore as required in the current manual of survey instructions of the United States Department of the Interior, Bureau of Land Management or by a decree of a Court of Law and for that the corner points mentioned in lines 3, 4 and 5 above were in conformance with the rules of the Michigan Board of Professional Surveyors or by a Decree of a Court of Law; established, re-established, monumented, re-monumented, covered, found as expressed below:

NOTE: Not more than 2 corners, all in the same town and range, may be recorded on this certificate.


Description of original monument and accessories and/or subsequent restoration:

- 1840 Original Survey John Mullett Set wood post 12" Spruce N46°E 12 lks
10" ash S11°W 17 lks
- 1964 DNR - LCRC Ken Larsen # 10695 1" pipe w/4" brass cap
- 1972 Survey Orlando Doyle # 7319 1" pipe w/brass cap
- 1973 LCRC 1" pipe w/brass cap

Description of corner evidence found and/or method applied in restoring or reestablishing corner:

Found DNR monument with brass cap.

Marvin A. Ross

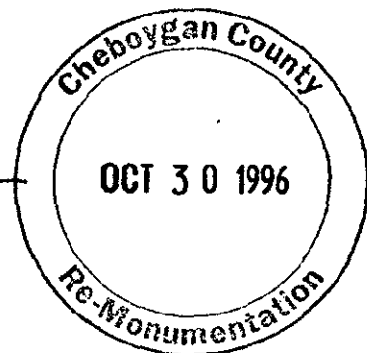


LIBER 010 PAGE 172

Description of monument for corner and accessories established to perpetuate locating the position of the corner:

also corner A-5, T38N, R2W

DNR monument with brass cap

- 2" Poplar S54°E 79.37' Set nail w/tag
- 2" Poplar S20°E 53.42' Set nail w/tag
- 1" Birch S20°W 60.28' Set nail w/tag
- 3" Birch S49°W 77.31' Set nail w/tag

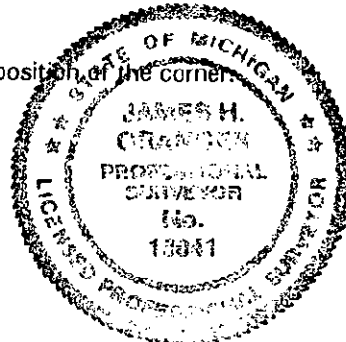

by James H. Granger

Date 10-10-96

Surveyor's Michigan License No. 16041