

SURVEY & REMONUMENTATION
CHEBOYGAN COUNTY REMONUMENTATION CORNER
LAND CORNER RECORDATION CERTIFICATE
Filing Requirement of Act 74, Mich. P.A. 1970

MAY 05 1997

corners in
 CHEBOYGAN

COMMISSION

Located In:

Corner Code #

(County)

Public Land Survey T 38N R 3W Corner Code # M-6
 T ___ R ___
 T ___ R ___
 T ___ R ___
 T ___ R ___
 Property Controlling S ___ T ___ R ___
 in Section S ___ T ___ R ___
 Miscellaneous S ___ T ___ R ___
 Property in Sec. S ___ T ___ R ___

RECEIVED
 FOR RECORD
 96 OCT 30 PM 12:13

James Gray
 CLERK/REGISTER
 CHEBOYGAN COUNTY, MICHIGAN
 Register of Deeds Stamp & File Number

Lot No. _____, Recorded Plat _____
 Private Claims _____

	A	B	C	D	E	F	G	H	I	J	K	L	M
1													
2	6		5		4		3		2		1		
3													
4	7		8		9		10		11		12		
5													
6	18		17		16		15		14		13		
7													
8	19		20		21		22		23		24		
9													
10	30		29		28		27		26		25		
11													
12	31		32		33		34		35		36		
13													

JAMES H. GRANGER, in a field survey on OCTOBER 18, 19 96
 hereby state that under requirements of P.A. 74, Michigan P.A. of 1970, the corner points
 mentioned in lines 1 and 2 above were in conformance with regulations and rules therefore as
 required in the current manual of survey instructions of the United States Department of the Interior,
 Bureau of Land Management or by a decree of a Court of Law and /or that the corner points
 mentioned in lines 3, 4 and 5 above were in conformance with the rules of the Michigan Board of
 Land Surveyors or by a Decree of a Court of Law; established, re-established, monumented,
 discovered, found as expressed below:

NOTE: Not more than 2 corners, all in the same town and range, may be recorded
 on this certificate.


Description of original monument and accessories and/or subsequent restoration:

40 - Original Survey Set wood post 10" Tamarack N42°E 8 lks
 John Mullett 8" Tamarack S50°W 12 lks
 #64 - DNR-LCRC Set 1" pipe w/4" brass cap
 Ken Larsen #10695

Description of corner evidence found and/or method applied in restoring or reestablishing corner:

Found 1" pipe with 4" brass cap and set four witnesses.

Marcia Rose

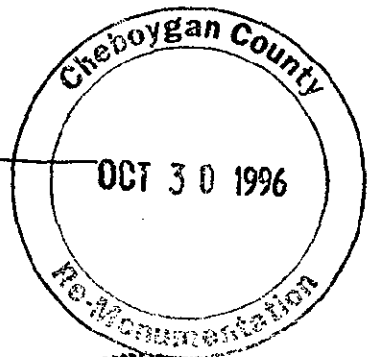


LIBER 010 PAGE 173

Description of monument for corner and accessories established to perpetuate locating the position of the corner:

also corner A-6, T38N, R2W

pipe

Balsam N 47°W 9.33'
 Poplar N33°E 16.46'
 Poplar S20°E 1.57'
 Poplar S40°W 30.12'

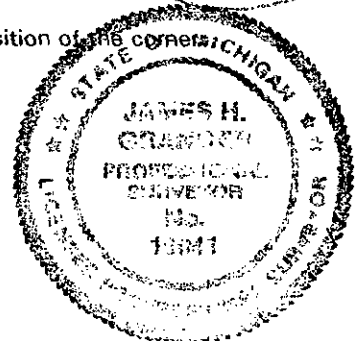

Recorded by James H. Granger
 Surveyor's Michigan License No. 16041

Date 10-18-96