

SURVEY & REMONUMENTATION

CHEBOYGAN COUNTY REMONUMENTATION CORNER

LAND CORNER RECORDATION CERTIFICATE
Filing Requirement of Act 74, Mich. P.A. 1970

MAY 05 1997

3 or corners in CHEBOYGAN

COMMISSION

Located In:

Corner Code #

(County)

Public Land Survey	T <u>38N</u> R <u>3W</u>	<u>M-10</u>
	T _____ R _____	_____
	T _____ R _____	_____
	T _____ R _____	_____
Property Controlling in Section	S _____ T _____ R _____	_____
	S _____ T _____ R _____	_____
Miscellaneous Property in Sec.	S _____ T _____ R _____	_____
	S _____ T _____ R _____	_____

RECEIVED FOR RECORD
 96 OCT 30 PM 12:19
James H. Granger
 CLERK/REGISTER
 CHEBOYGAN COUNTY, MICHIGAN
 Register of Deeds Stamp & File Number

Lot No. _____, Recorded Plat _____

Private Claims _____

1	A	B	C	D	E	F	G	H	I	J	K	L	M
2	6		5		4		3		2		1		
3													
4	7		8		9		10		11		12		
5													
6	16		17		16		15		14		13		
7													
8	19		20		21		22		23		24		
9													
10	30		29		28		27		26		25		
11													
12	31		32		33		34		35		36		
13													

AMES H. GRANGER, in a field survey on SEPTEMBER 24, 19 96 hereby state that under requirements of P.A. 74, Michigan P.A. of 1970, the corner points mentioned in lines 1 and 2 above were in conformance with regulations and rules therefore as required in the current manual of survey instructions of the United States Department of the Interior, Bureau of Land Management or by a decree of a Court of Law and/or that the corner points mentioned in lines 3, 4 and 5 above were in conformance with the rules of the Michigan Board of Professional Surveyors or by a Decree of a Court of Law; established, re-established, monumented, re-monumented, found as expressed below:

NOTE: Not more than 2 corners, all in the same town and range, may be recorded on this certificate.


Description of original monument and accessories and/or subsequent restoration:

1840 Original Survey Set wood post 10" Tamarack S50°W 8 lks
 John Mullett 8" Cedar N51°E 20 lks

Description of corner evidence found and/or method applied in restoring or reestablishing corner:

Found 1/2" iron with cap # 25785/21568 and four witnesses.

Maurice P...

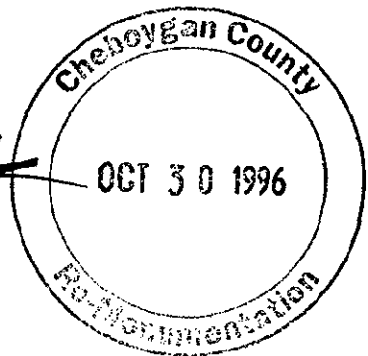


LIBER 010 PAGE 177

Description of monument for corner and accessories established to perpetuate locating the position of the corner, also corner A-10, T38N, R2W

Set 5/8" x 30" rebar with Remonumentation Cap

2" Iron			
4" Cedar	N09°W	8.74'	Fd tag
3" Cedar	N45°E	18.93'	Fd tag
3" Cedar	S55°E	13.72'	Fd tag
4" Cedar	S31°W	9.36'	Fd tag

Maurice P...

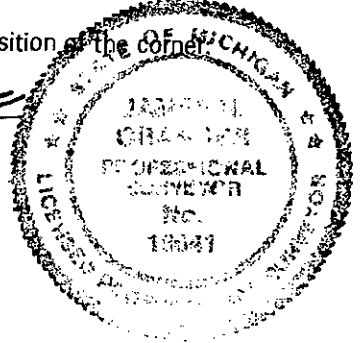

Set by James H. Granger

Date 10-10-96

Surveyor's Michigan License No. 16041