

SURVEY & REMONUMENTATION

CHEBOYGAN COUNTY REMONUMENTATION CORNER

LAND CORNER RECORDATION CERTIFICATE
Filing Requirement of Act 74, Mich. P.A. 1970

MAY 05 1997

corners in CHEBOYGAN COMMISSION Located In: Corner Code #

Public Land Survey T 38N R 3W Corner Code # M-11
 T _____ R _____
 T _____ R _____
 T _____ R _____
 Property Controlling S _____ T _____ R _____
 in Section S _____ T _____ R _____
 Miscellaneous S _____ T _____ R _____
 Property in Sec. S _____ T _____ R _____

RECEIVED FOR RECORD
 96 OCT 30 PM 12:20
James H. Granger
 CLERK/REGISTER
 CHEBOYGAN COUNTY, MICHIGAN
 Register of Deeds Stamp & File Number

Lot No. _____, Recorded Plat _____
 Private Claims _____

AMES H. GRANGER, in a field survey on SEPTEMBER 24, 1996, hereby state that under requirements of P.A. 74, Michigan P.A. of 1970, the corner points mentioned in lines 1 and 2 above were in conformance with regulations and rules therefore as required in the current manual of survey instructions of the United States Department of the Interior, Bureau of Land Management or by a decree of a Court of Law and /or that the corner points mentioned in lines 3, 4 and 5 above were in conformance with the rules of the Michigan Board of Land Surveyors or by a Decree of a Court of Law; established, re-established, monumented, covered, found as expressed below:

NOTE: Not more than 2 corners, all in the same town and range, may be recorded on this certificate.

	A	B	C	D	E	F	G	H	I	J	K	L	M
1													
2	6		5		4		3		2			1	
3													
4	7		8		9		10		11			12	
5													
6	18		17		16		15		14			13	
7													
8	19		20		21		22		23			24	
9													
10	30		29		28		27		26			25	
11													
12	31		32		33		34		35			36	
13													

Description of original monument and accessories and/or subsequent restoration:

- 1840 Original Survey John Muffett Set wood post 10" Cedar N12°E 17 lks
 8" Ash S45°W 11 lks
- 1964 DNR - LCRC Ken Larsen # 10695 Set 1" pipe w/4" brass cap
- 1977 LCRC Orlando Doyle # 7319 Found 1" pipe w/brass cap
- 1984 Survey Orlando Doyle # 7319 Found 1" pipe w/brass cap

Description of corner evidence found and/or method applied in restoring or reestablishing corner:



Found concrete monument, Three DNR witnesses and one Doyle Witness *Martin P. Rose*

LIBER 010 PAGE 178

Description of monument for corner and accessories established to perpetuate locating the position of the corner:

also corner A-11, T38N, R2W
 concrete Monument with Remonumentation Cap

- 4" Cedar N33°W 17.58' Fd nail & washer
- 5" Cedar N50°E 16.94' Fd nail & washer
- 5" Maple S61°E 45.43' Fd spike
- 3" Cedar S20°E 39.59' Fd spike

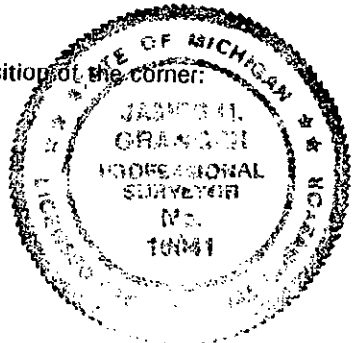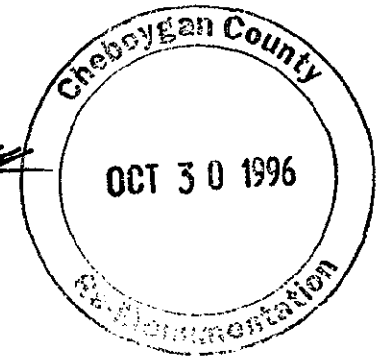

Recorded by James H. Granger
 Surveyor's Michigan License No. 16041

Date 10-10-96