

SURVEY & REMONUMENTATION CHEBOYGAN COUNTY REMONUMENTATION CORNER

MAY 05 1997

LAND CORNER RECORDATION CERTIFICATE
Filing Requirement of Act 74, Mich. P.A. 1970

corners in
CHEBOYGAN COMMISSION

(County)	Located In:	Corner Code #
Public Land Survey	T <u>38N</u> R <u>3W</u>	<u>M-12</u>
	T _____ R _____	_____
	T _____ R _____	_____
	T _____ R _____	_____
Property Controlling in Section	S _____ T _____ R _____	_____
	S _____ T _____ R _____	_____
Miscellaneous Property in Sec.	S _____ T _____ R _____	_____
	S _____ T _____ R _____	_____

RECEIVED FOR RECORD
96 OCT 30 PM 12:22
Jasmo Spray
CLERK/REGISTER
CHEBOYGAN COUNTY, MICHIGAN

Register of Deeds Stamp & File Number

Lot No. _____, Recorded Plat _____
Private Claims _____

AMES H. GRANGER, in a field survey on SEPTEMBER 24, 1996 hereby state that under requirements of P.A. 74, Michigan P.A. of 1970, the corner points mentioned in lines 1 and 2 above were in conformance with regulations and rules therefore as prescribed in the current manual of survey instructions of the United States Department of the Interior, Bureau of Land Management or by a decree of a Court of Law and/or that the corner points mentioned in lines 3, 4 and 5 above were in conformance with the rules of the Michigan Board of Licensed Surveyors or by a Decree of a Court of Law; established, re-established, monumented, discovered, found as expressed below:

	A	B	C	D	E	F	G	H	I	J	K	L	M
1													
2	6		5		4		3		2		1		
3													
4	7		8		9		10		11		12		
5													
6	18		17		16		15		14		13		
7													
8	19		20		21		22		23		24		
9													
10	30		29		28		27		26		25		
11													
12	31		32		33		34		35		36		
13													

NOTE: Not more than 2 corners, all in the same town and range, may be recorded on this certificate.


Description of original monument and accessories and/or subsequent restoration:

- 1840 Original Survey John Mullett Set wood post 24" Sugar N28°W 21 lks
24" Lynn S48°E 32 lks
- 1972 Survey Orlando Doyle # 7319 1" pipe
- 1987 Survey Orlando Doyle # 7319 1" pipe

Description of corner evidence found and/or method applied in restoring or reestablishing corner:

Found 3/4" pipe and three Doyle witnesses.

Marion A. Ray

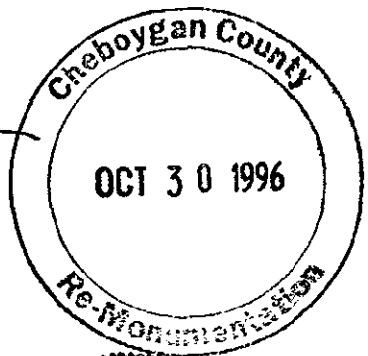


LIBER 010 PAGE 179

Description of monument for corner and accessories established to perpetuate locating the position of the corner:

also corner A-12, T38N, R2W

set 5/8" x 30" rebar with Remonumentation Cap

- 10" Cedar S36°E 63.13' Fd tag
- 4" Maple N30°E 25.74' Set nail w/tag
- 6" S. Pine N75°W 26.95' Fd tag
- 6" S. Pine N40°W 19.87' Fd tag

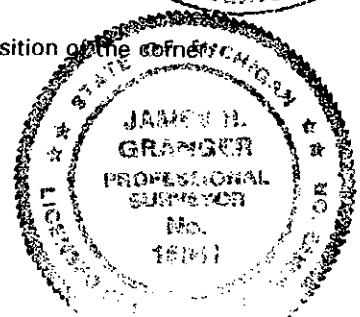

Recorded by James H. Granger
Surveyor's Michigan License No. 16041

Date 10-10-96