

**SURVEY &  
REMONUMENTATION/CHEBOYGAN COUNTY REMONUMENTATION CORNER**

MAY 05 1997

**LAND CORNER RECORDATION CERTIFICATE  
Filing Requirement of Act 74, Mich. P.A. 1970**

corners in CHEBOYGAN	<b>COMMISSION</b>	Located In:	Corner Code #
(County)			
Public Land Survey	T <u>38N</u> R <u>3W</u>		<u>M-13</u>
	T _____ R _____		_____
	T _____ R _____		_____
	T _____ R _____		_____
Property Controlling in Section	S _____ T _____ R _____		_____
	S _____ T _____ R _____		_____
Miscellaneous	S _____ T _____ R _____		_____
Property in Sec.	S _____ T _____ R _____		_____

RECEIVED  
FOR RECORD  
96 OCT 30 PM 12:23  
*James H. Granger*  
CLERK/REGISTER  
CHEBOYGAN COUNTY, MICHIGAN  
Register of Deeds Stamp & File Number

Lot No. \_\_\_\_\_, Recorded Plat \_\_\_\_\_  
Private Claims \_\_\_\_\_

MES H. GRANGER, in a field survey on SEPTEMBER 24, 19 96  
hereby state that under requirements of P.A. 74, Michigan P.A. of 1970, the corner points  
mentioned in lines 1 and 2 above were in conformance with regulations and rules therefore as  
prescribed in the current manual of survey instructions of the United States Department of the Interior,  
Bureau of Land Management or by a decree of a Court of Law and for that the corner points  
mentioned in lines 3, 4 and 5 above were in conformance with the rules of the Michigan Board of  
Professional Surveyors or by a Decree of a Court of Law; established, re-established, monumented,  
re-monumented, found as expressed below:

	A	B	C	D	E	F	G	H	I	J	K	L	M
1													
2	6			5			4			3		2	1
3													
4	7			8			9			10		11	12
5													
6	18			17			16			15		14	13
7													
8	19			20			21			22		23	24
9													
10	30			29			28			27		26	25
11													
12	31			32			33			34		35	36
13													

**NOTE:** Not more than 2 corners, all in the same town and range, may be recorded on this certificate.

**Description of original monument and accessories and/or subsequent restoration:**


- 1840 Original Survey                      Set wood post 8" Spruce N55°E 12 lks  
John Mullett                                      8" Spruce S51°W 6 lks
- 19772 LCRC                                      Set 3/4" pipe  
Orlando Doyle # 7319

**Description of corner evidence found and/or method applied in restoring or reestablishing corner:**

Found 3/4" pipe and three Doyle witnesses overgrown.

*Mount. Post*


LIBER **010** PAGE **180**

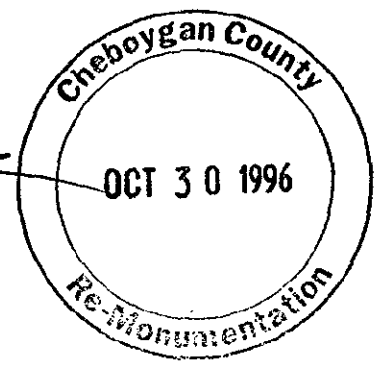

**Description of monument for corner and accessories established to perpetuate locating the position of the corner**

**also corners A-13, T38N, R2W A-1, T37N, R2W M-1 T37N, R3W**

- 5/8" x 30" rebar with Remonumentation Cap
- Tamarack N23°W 7.41' Set nail w/tag
- Tamarack N43°E 10.56' Set nail w/tag
- Tamarack S76°E 5.08' Set nail w/tag
- Tamarack S39°W 5.82' Set nail w/tag

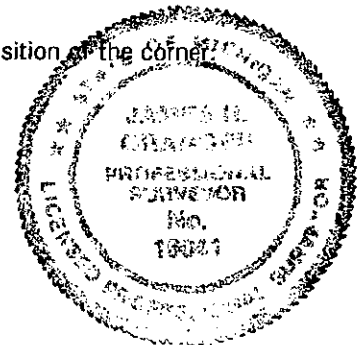

by *James H. Granger*  
Surveyor's Michigan License No. 16041

Date 10-10-96