


Form 976.

T. 38 N

R. 3 W

Mos.

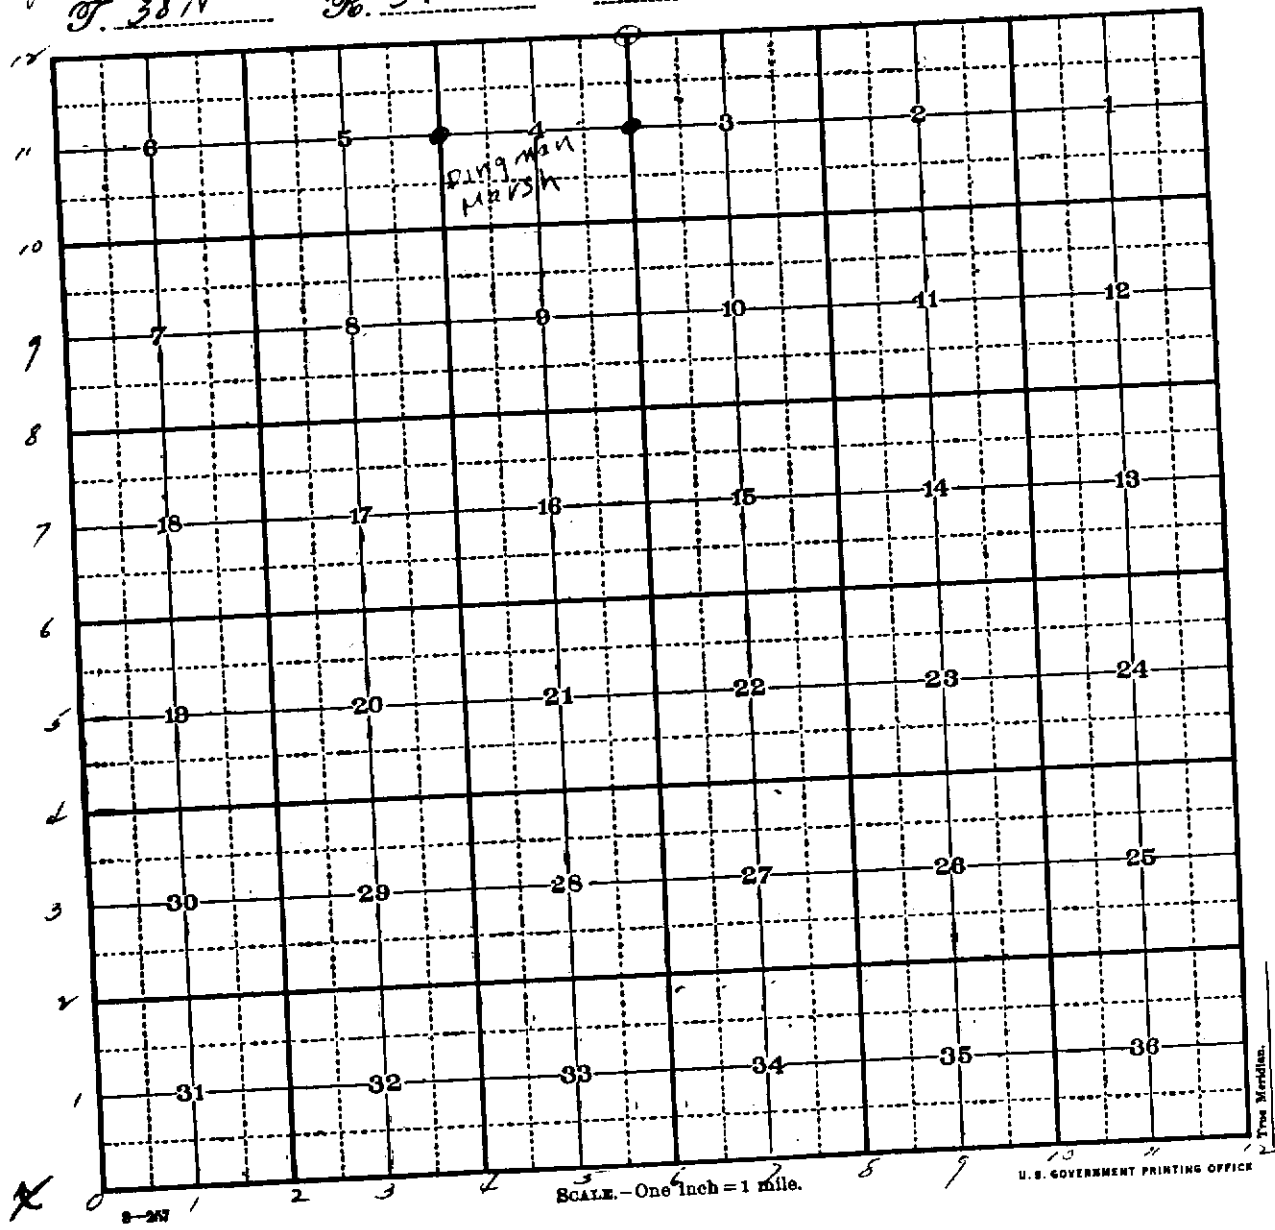

8-283

SCALE - One inch = 1 mile.

U.S. GOVERNMENT PRINTING OFFICE

True Meridian.

K

y