

MICHIGAN  
DEPARTMENT OF CONSERVATION  
FORESTRY DIVISION

# LAND CORNER RECORD

T. 39 N.R. 3 W


Cheboygan COUNTY

DESCRIPTION OF CORNER SW Corner of Private Claim #334 in Section 33

CORNER MONUMENT 1" pipe with 4" Aluminum cap

DATE MONUMENT PLACED AND WITNESSED 8-30-61

WITNESSES TO CORNER.....

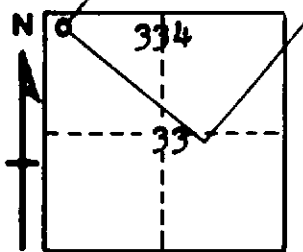

5" W. Birch - N76W - 1.7 feet

5" Maple -- S22W - 31.0 feet

AND

CIRCLE CORNER REGISTERED

DESCRIPTION IN DETAIL AS TO HOW CORNER WAS LOCATED AND IDENTIFIED OR RESTORED.

This corner was set on NW<sup>ly</sup> boundary of Private Claim at record measurement SW<sup>ly</sup> from original closing corner between Sections 28 and 33. Set corner S36°55'W 4.27 chains from closing corner. See map and Minutes of Survey for more information.

SURVEYOR'S SEAL

SIGNED Kenneth J. Ostling DATE 9/18/61  
REGISTERED AND SURVEYOR