

SURVEY & REMONUMENTATION

JAN 31 2001

SECTION

LAND CORNER RECORDATION CERTIFICATE
Filing Requirement of Act 74, Mich. P.A. 1970

Approved By Delta County
Land Survey Remonumentation
Peer Group Under Act 345 of
P.A. Of 1990 On 12/22, 2000
Cheryl Schmelzer
Acting Chairman

For corners in

<u>DELTA</u> (County)	Located In:	Corner Code #
1. Public Land Survey	T 37 NR 19 W T 37 NR 19 W T R T R	I-02 I-03 ✓
2. Property Controlling in Section	S T R	
3. Miscellaneous	S T R	
Property in Sec.	S T R	
	1-02 [W1/4 COR SEC 2]	I-03 [NW COR SEC 11]

RECORDED 08 January 2001
AT 9:00 O'CLOCK A.M.
LIBER 9 PAGE 245
Nancy O. Kolich
DELTA COUNTY REG. OF DEEDS
Register of Deeds Stamp & File Number

4. Lot No. _____, Recorded Plat _____
5. Private Claims _____

I, M.P. DAVIS, in a field survey on NOVEMBER, 2000 do hereby state that under requirements of P.A. 74, Michigan P.A. of 1970, the corner points mentioned in lines 1 and 2 above were in conformance with regulations and rules therefore as required in the current manual of survey instructions of the United States Department of the Interior, Bureau of Land Management or by a decree of a Court of Law and/or that the corner points mentioned in lines 3, 4 and 5 above were in conformance with the rules of the Michigan Board of Land Surveyors or by a Decree of a Court of Law; established, re-established, monumented, recovered, found as expressed below:

NOTE: Not more than 2 corners, all in the same town and range, may be recorded on this certificate.


A	B	C	D	E	F	G	H	I	J	K	L	M
1												
2	6	5	4	3	2							
3												
4	7	8	9	10	11	12						
5												
6	18	17	16	15	14	13						
7												
8	19	20	21	22	23	24						
9												
10	30	29	28	27	26	25						
11												
12	31	32	33	34	35	36						
13												

A. Description of original monument and accessories and/or subsequent restoration:

- I-02 [W1/4 COR SEC 2] ALGERNON MERRYWEATHER, D.S.-1848-WOOD POST-(BALSAM 05" N46°W 11 LINKS)(TAMARACK 10" S47°E 16 LINKS) M.S.McNABB-1920-ID BY ORIGINALS-MADE + IN STONE LEDGE (SPRUCE 3" NORTH 17.6')(SPRUCE 3" EAST 26.4')(WOOD STAKE SOUTH 6")
- I-03 [NW COR SEC 11] ALGERNON MERRIWEATHER, D.S.-1848-WOOD POST-(BALSAM 09" N70°E 20 LINKS)(BALSAM 10" S65°W 10 LINKS) T.OBRIEN-1985-L.5 OF LCR'S PG.255-FOUND WOOD POST IN PLACE-SET 1/2" IRON BAR W/A SURVEY CAP (CEDAR 10" N74°E 37.6')(CEDAR 10" N40°W 20.7')

B. Description of corner evidence found and/or method applied in restoring or reestablishing corner:

- I-02 [W1/4 COR SEC 2] FOUND IN PLACE REMAINS OF McNABB'S WITNESS POST. NO EVIDENCE OF HIS + ON THE STONE LEDGE AS IT APPEARS TO HAVE FRACTURED A NUMBER OF TIMES OVER THE YEARS. RESTORED COR POSITION 6" NORTH OF WOOD POST AS THIS POSITION CHECKS WELL WITH THE RECORDS OF McNABB FOR ALIGNMENT & DISTANCE TO HIS N1/16 COR & THE NW COR OF SEC 2. ACCEPTED THIS LOCATION AS BEING A CAREFUL & FAITHFUL PERPETUATION OF THE POSITION OF THE ORIGINAL CORNER.
- I-03 [NW COR SEC 11] FOUND IN PLACE A 1/2" IRON BAR W/A SURVEY CAP AND REMAINS OF A SQ'D WOOD POST- ID SAME AS THAT SET IN 1984 BY T.OBRIEN FROM HIS RECORDED BT'S WHICH ARE NOW BOTH BLOW DOWNS. ACCEPTED EXISTING MONUMENT AS BEING THE BEST AVAILABLE EVIDENCE AS TO THE LOCATION OF THE POSITION OF THE ORIGINAL CORNER.

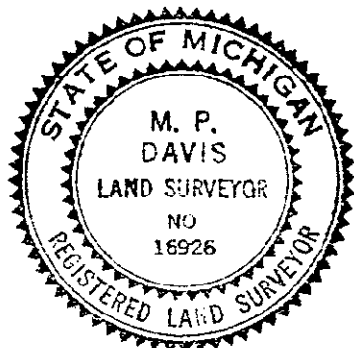

C. Description of monument for corner and accessories established to perpetuate locating the position of the corner:

- I-02 SET IN A DRILL HOLE IN THE LEDGE ROCK A 5/8" X 18" REBAR W/A 3-1/4' ALUM CAP STAMPED TO ID THE CORNER POSITION.

CEDAR 11"	BALSAM 08"	BALSAM 07"	WHITE BIRCH 06"
WEST	N20°E	S75°E	S15°W
18.21'	29.15'	29.56'	27.96'
- I-03 SET OVER EXISTING MON A BERNTSEN A1NB30 ALUM MONUMENT WITH THE CAP STAMPED TO ID THE COR POSITION.

CEDAR 13"	CEDAR 09"	CEDAR 25"	CEDAR 17"
S85°W	N41°E	S85°E	S12°W
11.04'	23.04'	23.44'	4.16'

NOTE: BEARINGS TO REFERENCE OBJECTS ARE MAGNETIC-DISTANCES ARE TO A NAIL W/A DELTA COUNTY REFERENCE TAG, UNLESS OTHERWISE NOTED.

Signed by M.P. Davis
Surveyor's Michigan License No. 16926

Date 12/23/00