

FEB 2 2 1996

5

H

For corners in

1. Public Land Su

Property in Sec.

Approved By Delta County

	Lanu	oui ve	y neu	ionume:	ntati o n	
	Pee	r Group	D Und	er Act 3	45 Of	
' .A.				126		5

COMMISSION

LAND CORNER RECORDATION CERTIFICATE

	Filing Requirement of Act 74, Mich. P.A. 1970				
corners in DELTA	Located In:	Corner Code ##			
(County)					
Public Land Survey	T <u>38</u> NR <u>24</u> W	G-13 & H-1	Recorded Ot 27 1995		
	т <u>ЭЭ</u> И R 24W	(G-1)	at 9:00 o'clock AM in Liber 8 Page 107		
	T R		Walters C. Zhou Reg. of Deeds.		
Property Controlling	S T R		Delta County, Michigan		
in Section	S T R				
Miscellaneous	S T R		Register of Deeds Stamp & File Number		
Property in Sec.	S T R				

Private Claims G - 1318W COR S. 341 H-1 (N1/4 COR S.3) SAME AS G-1 T37N R24W SAME AS H-13 T39N R24W M.P. DAVIS in a field survey on . do hereby certify that under requirements of P.A. 74, Michigan P.A. of 1970, the corner points mentioned in lines 1 and 2 above were in conformance with regulations and rules therefore as required in the current manual of survey instructions of the United States Department of the Interior, Bureau of Land Management or by a decree of a Court of Law and/or that the corner points mentioned in lines 3, 4 and 5 above were in conformance with the rules of the Michigan Board of Land Surveyors or by a Decree of a Court of Law; established, re-established, monumented, re-monumented, recovered, found as expressed below:


, Recorded Plat .

3 8 q 10 11 12

NOTE: Not more than 4 corners, all in the same town and range, may be recorded on this certificate.

- Description of original monument and accessories and/or subsequent restoration:
 - G-13 [SW COR S.34] JAMES H. MULLETTE, D.S. 1847 WOOD POST (Y.BIRCH 10"-N63°E-21 LINKS) (Y.BIRCH 08"-N58°W-45 LINKS) GEORGE ADAIR, D.S. - 1852 - WOOD POST - (CEDAR 12"-SO5°W-38 LINKS) (CEDAR 16"-S21°E-43 LINKS) from survey of 737N R24N M.S.McNABB-1918-IDENTIFIED BY ORIGINAL CEDAR BT, NOW A 16" STUMP, RESET STAKE & BT STAKES NW & SE 33' F.BRAY-M.D.N.R.-1969-SET 1-1/4" I.P. FROM OCCUPATION & WHERE LAND OWNER RECALLS SEEING A WOOD STAKE IN PLACE (COR POST-SOUTH-29 LINKS) (GUARD RAIL POST-S71°E-44 LINKS) (GUARD RAIL POST-N70°E-46 LINKS)
 - H-1 [N1/4 COR S.3] JAMES H. MULLETTE, D.S. 1848 WOOD POST (TAMARACK 08"-N57°W-40 LINKS) (TAMARACK 06"-S71°W-07 LINKS) NO RECORD EVIDENCE OF SUBSEQUENT CORNER RECOVERY OR MONUMENTATION
- Description of corner evidence found and/or method applied in restoring or reestablishing corner: G-13 [SW COR S.34] FOUND IN PLACE THE ABOVE MENTIONED MONUMENT AS PLACED BY FRANK BRAY IN 1969,

ID CORNER MONUMENT BY REFERENCE TO BOTH GUARD RAIL BT'S AS NOTED IN BRAY'S LCR RECORDED IN LIBER 4 ON PAGE 81. ACCEPTED EXISTING MONUMENT AS BEING THE BEST AVAILABLE EVIDENCE AS TO THE POSITION OF THE ORIGINAL CORNER.

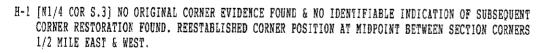



- C. Description of monument for corner and accessories established to perpetuate locating the position of the corner:
 - G-13 SET OVER EXISTING MON A 5/8" X 18" REBAR N/A 31/4" ALUMN CAP STAMPED TO ID THE CORNER POSITION.

ELM 9" END GUARD RAIL POST END GUARD RAIL POST

POWER POLE

SURVEY MONUMENT SIGN POST

N36°W N70°E S71°E 15.30 31.26' (TO FACE) 34.94' (TO FACE)

S65°W 72.20' (TO FACE)

SOUTH 17.13' (TO FACE)

H-1 SET BERNTSEN ALMB30 ALUMN MONUMENT W/A 31/4" CAP STAMPED TO ID THE CORNER POSITION.

TAMARACK 6" TAMARACK 6" TAMARACK 5" TAMARACK 5" SURVEY MONUMENT SIGN POST N32°E \$72° € S20°E S52°₩ NORTH 6.91 1.95' (TO FACE) 31.11 24 81 19.71'

NOTE: BEARINGS TO REFERENCE OBJECTS ARE MAGNETIC - DISTANCES ARE TO A NAIL IN THE CENTER OF THE OBJECT UNLESS NOTED OTHERWISE

Signed by

Date