

FEB 22 1996  
COMMISSION

Approved By Delta County  
Land Survey Remonumentation  
Peer Group Under Act 345 Of  
P.A. Of 1990 On 10/26, 1995

LAND CORNER RECORDATION CERTIFICATE  
Filing Requirement of Act 74, Mich. P.A. 1970

*Phyllis Mulvey*  
Acting Chairman

For corners in DELTA (County) Located in: Corner Code ##

1. Public Land Survey	T <u>33</u> N R <u>24</u> W	<u>L-13 &amp; M-13</u>
	T <u>37N</u> R <u>24W</u>	<u>M-1</u>
	T _____ R _____	_____
2. Property Controlling in Section	S _____ T _____ R _____	_____
3. Miscellaneous Property in Sec.	S _____ T _____ R _____	_____

Recorded Oct 27 1995  
at 9:00 o'clock AM in Liber 8 Page 111  
*William C. Thomas* Reg. of Deeds.  
Delta County, Michigan

Register of Deeds Stamp & File Number

4. Lot No. \_\_\_\_\_, Recorded Plat \_\_\_\_\_  
5. Private Claims \_\_\_\_\_  
L-13 [S1/4 COR S.36] SAME AS L-1 T37N R24W  
M-13 [SE COR S.36] SAME AS (M-1 T37N R24W), (A-13 T38N R23W) & (A-1 T37N R23W)

	A	B	C	D	E	F	G	H	I	J	K	L	M
2	6		5		4		3		2		1		
3													
4	7		8		9		10		11		12		
5													
6	18		17		16		15		14		13		
7													
8	19		20		21		22		23		24		
9													
10	30		29		28		27		26		25		
11													
12	31		32		33		34		35		36		
13													

I, M.P. DAVIS in a field survey on DECEMBER, 19 94, do hereby certify that under requirements of P.A. 74, Michigan P.A. of 1970, the corner points mentioned in lines 1 and 2 above were in conformance with regulations and rules therefore as required in the current manual of survey instructions of the United States Department of the Interior, Bureau of Land Management or by a decree of a Court of Law and/or that the corner points mentioned in lines 3, 4 and 5 above were in conformance with the rules of the Michigan Board of Land Surveyors or by a Decree of a Court of Law; established, re-established, monumented, re-monumented, recovered, found as expressed below:

NOTE: Not more than 4 corners, all in the same town and range, may be recorded on this certificate.

A. Description of original monument and accessories and/or subsequent restoration:


L-13 [S1/4 COR S.36] JAMES H. MULLETTE D.S. 1847-WOOD POST -(CEDAR 14"-N63°E-53 LINKS) (LYNN 14"-S45°W-10 LINKS)  
NO RECORD EVIDENCE OF SUBSEQUENT CORNER RECOVERY OR MONUMENTATION

M-13 [SE COR S.36] JOHN BURT, D.S. - 1845 - CEDAR 05", CORNER TREE - (TANARACK 10"-S75°W-11 LINKS) (CEDAR 07"-N65°E-28 LINKS)  
K.S. McNABB-1917-FOUND STAKE IN PLACE AT INTERS OF ROAD SOUTH & WEST - NO WIT'S NOTED IN HIS RECORDS  
K.S. McNABB-1925-STAKE FROM PREVIOUS SURVEY-SET I.P. (COR FENCE POST-N68°E-36.5') (BALM OF GILEAD STUMP 18"-N18°E-17.5')

B. Description of corner evidence found and/or method applied in restoring or reestablishing corner:

L-13 [S1/4 COR S.30] NO ORIGINAL CORNER EVIDENCE FOUND & NO IDENTIFIABLE INDICATION OF SUBSEQUENT CORNER RESTORATION FOUND. ESTABLISHED CORNER POSITION AT JCT OF ANCIENT FENCE LINES WEST & SOUTH THIS POSITION BEST FITS COUNTY ROAD IMPROVEMENTS NORTH & EAST. ACCEPTED THIS POSITION AS BEING THE BEST AVAILABLE EVIDENCE AS TO THE LOCATION OF THE POSITION OF THE ORIGINAL CORNER.

M-13 [SE COR S.36] FOUND IN PLACE AT THE APPROX. C/L PI OF THE COUNTY ROAD McNABB'S 1925 I.P. ACCEPTED THE EXISTING MONUMENT AS BEING THE BEST AVAILABLE EVIDENCE AS TO THE LOCATION OF THE POSITION OF THE ORIGINAL CORNER.

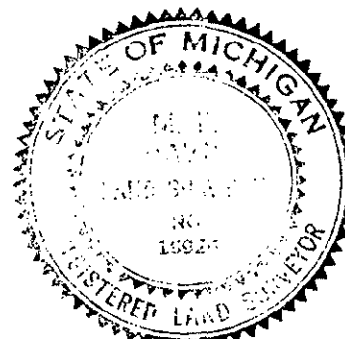

C. Description of monument for corner and accessories established to perpetuate locating the position of the corner:

L-13 SET A 5/8" X 18" REBAR W/A 3 1/4" ALUMN CAP STAMPED TO ID THE CORNER POSITION.  
CEDAR 12" CEDAR 8" WHITE BIRCH 4" SURVEY MONUMENT SIGN POST  
S57°W S25°W S57°E SOUTH  
35.78' 26.30' 33.54' 2.60' (TO FACE)

M-13 REPLACED EXISTING I.P. W/A 4" X 4" X 36" CONC MON W/A 3" BRASS CAP STAMPED TO ID THE CORNER POSITION  
CEDAR 6" CEDAR 5" SURVEY MONUMENT SIGN POST NOTE: FARM FIELDS IN THE  
N71°E S11°E NORTH NW & SW QUADRANTS.  
37.24' 110.75' 1/44' (TO FACE)

NOTE: BEARINGS TO REFERENCE OBJECTS ARE MAGNETIC - DISTANCES ARE TO A NAIL IN THE CENTER OF THE OBJECT UNLESS NOTED OTHERWISE

Signed by M.P. Davis Date 10/24/95

Surveyor's Michigan License No. 16926