

**SURVEY & REMONUMENTATION**

**OCT 03 2000**

**SECTION**

**LAND CORNER RECORDATION CERTIFICATE**  
Filing Requirement of Act 74, Mich. P.A. 1970

Approved By Delta County  
Land Survey Remonumentation  
Peer Group Under Act 345 of  
P.A. of 1990 On July 12, 2000

Walter C. Dumas  
Acting Chairman

For corners in

<u>DELTA</u> (County)	Located In:	Corner Code #
1. Public Land Survey	T 38 NR 19 W	<input checked="" type="checkbox"/> A-09 SAME
	T 38 NR 20 W	M-09 CORNER
	T 38 NR 19 W	I-13 SAME
	T 37 NR 19 W	I-01 CORNER
2. Property Controlling in Section	S ___ T ___ R ___	_____
	S ___ T ___ R ___	_____
3. Miscellaneous Property in Sec.	S ___ T ___ R ___	_____
	S ___ T ___ R ___	_____

RECORDED 28 July 2000  
AT 9:00 O'CLOCK a.m.  
LIBER 9 PAGE 235  
Walter C. Dumas  
DELTA COUNTY MI REG. OF DEEDS

Register of Deeds Stamp & File Number

4. Lot No. \_\_\_\_\_, Recorded Plat \_\_\_\_\_  
5. Private Claims \_\_\_\_\_

I, M.P. DAVIS, in a field survey on MAY, 2000 do hereby state that under requirements of P.A. 74, Michigan P.A. of 1970, the corner points mentioned in lines 1 and 2 above were in conformance with regulations and rules therefore as required in the current manual of survey instructions of the United States Department of the Interior, Bureau of Land Management or by a decree of a Court of Law and/or that the corner points mentioned in lines 3, 4 and 5 above were in conformance with the rules of the Michigan Board of Land Surveyors or by a Decree of a Court of Law, established, re-established, monumented, recovered, found as expressed below:

NOTE: Not more than 2 corners, all in the same town and range, may be recorded on this certificate.

	A	B	C	D	E	F	G	H	I	J	K	L	M
1													
2		6		5		4		3		2		1	
3													
4		7		8		9		10		11		12	
5													
6		10		17		16		15		14		13	
7													
8		19		20		21		22		23		24	
9													
10		30		29		28		27		26		25	
11													
12		31		32		33		34		35		36	
13													

A. Description of original monument and accessories and/or subsequent restoration:


A-09 [NW COR SEC 30] JOHN BURT, D.S.-1845-WOOD POST-(BEECH 06" N67°W 21 LINKS)(Y.BIRCH 06" S47°W 24 LINKS)  
ALGERNON MERRYWEATHER, D.S.-1848-(BEECH 10" N73°E 21 LINKS)(BUTTERNUT 14" S55°E 68 LINKS)  
M.S.McNABB-1946-RESTORED CORNER POSITION FROM IMPROVEMENTS-SET CEDAR STAKE-(W.BIRCH 15: S32°E 18.2')(W.ASH 9" N60°E 34.6')  
M.DAVIS-1973-FOUND IN PLACE, A 3/4" IRON PIN. ID CORNER MONUMENT AS BEING A PERPETUATION OF McNABB'S 1946 COR. FROM HIS W.BIRCH BT WHICH WAS DOWN AND IN POOR CONDITION. NO WIT'S NOTED.

I-13 [SW COR SEC 35] ALGERNON MERRYWEATHER, D.S.-1848-WOOD POST-(CEDAR 09" N25°W 11 LINKS)(CEDAR 08" N55°E 10 LINKS)  
M.S.McNABB-1916-ID FROM ORIGINALS-NO NEW WIT'S NOTED  
M.S.McNABB-1920-IRON STAKE IN PLACE FROM PREVIOUS SURVEY-ORIGINALS PLAIN-SET BT STAKES NW & SE 33'

B. Description of corner evidence found and/or method applied in restoring or reestablishing corner:

A-09 [NW COR SEC 30] FOUND IN PLACE A 3/4" IRON PIN. ID THE CORNER MONUMENT AS BEING THE SAME AS FOUND BY MYSELF IN 1973 BY DISTANCES TO ADJOINING CORNERS TO THE NORTH. ACCEPTED THE EXISTING MONUMENT AS BEING THE BEST AVAILABLE EVIDENCE AS TO THE LOCATION OF THE POSITION OF THE ORIGINAL CORNER.

I-13 [SW COR SEC 35] FOUND IN PLACE ON THE NORTH EDGE OF A E-W WOODS ROAD A 1" IRON PIN. NO EVIDENCE OF THE ORIGINAL BT'S OR McNABB'S BT STAKES FOUND. ID THE CORNER MONUMENT FROM THE RETRACEMENT OF McNABB'S 1920 SURVEY OF THE SOUTH LINE OF SEC 34. ACCEPTED THE EXISTING MONUMENT AS BEING A CAREFUL & FAITHFUL PERPETUATION OF THE POSITION OF THE ORIGINAL CORNER.

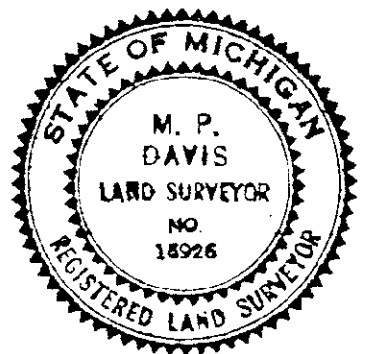

C. Description of monument for corner and accessories established to perpetuate locating the position of the corner:

A-09 SET, OVER EXISTING MONUMENT A BERNTSEN A1NB30 ALUM MONUMENT WITH THE CAP STAMPED TO ID THE CORNER POSITION.  

MAPLE 09"	BEECH 11"	MAPLE 15"	MAPLE 08"
N47°W	N74°E	S51°E	S17°W
24.08'	21.95'	63.23'	15.08'

I-13 SET, OVER EXISTING MONUMENT, A BERNTSEN A1NB30 ALUM MONUMENT WITH THE CAP STAMPED TO ID THE CORNER POSITION.  

CEDAR 07"	CEDAR 09"	CEDAR 06"	CEDAR 08"
N47°W	N46°E	S38°E	S56°W
15.58'	31.48'	30.06'	39.32'

NOTE: BEARINGS TO REFERENCE OBJECTS ARE MAGNETIC-DISTANCES ARE TO A NAIL W/A DELTA COUNTY REFERENCE TAG, UNLESS OTHERWISE NOTED.

Signed by M.P. Davis Date 7/13/00  
Surveyor's Michigan License No. 16926