

**SURVEY &  
REMONUMENTATION**

**JAN 14 1998**

**SECTION**

**LAND CORNER RECORDATION CERTIFICATE  
Filing Requirement of Act 74, Mich. P.A. 1970**

Approved By Delta County  
Land Survey Remonumentation  
Peer Group Under Act 345 Of  
P.A. Of 1990 On October 31, 1992  
*Robert Blumeling*  
Chairman

For corners in

DELTA  
(County)

Located In:

Corner Code ##

- |                                    |                             |                        |
|------------------------------------|-----------------------------|------------------------|
| 1. Public Land Survey              | T <u>38 N</u> R <u>19 W</u> | <u>B-07 &amp; C-08</u> |
|                                    | T _____ R _____             | _____                  |
|                                    | T _____ R _____             | _____                  |
|                                    | T _____ R _____             | _____                  |
| 2. Property Controlling in Section | S _____ T _____ R _____     | _____                  |
|                                    | S _____ T _____ R _____     | _____                  |
| 3. Miscellaneous Property in Sec.  | S _____ T _____ R _____     | _____                  |
|                                    | S _____ T _____ R _____     | _____                  |

Recorded Nov 5 1997  
9:00 AM  
Lib: 8 Page 239  
*William C. Thomas*

Register of Deeds Stamp & File Number

4. Lot No. \_\_\_\_\_, Recorded Plat \_\_\_\_\_  
5. Private Claims B-07 [N1/4 COR S19] C-08 [W1/4 COR S20]

	A	B	C	D	E	F	G	H	I	J	K	L	M
2	6	5	4	3	2	1							
3													
4	7	8	9	10	11	12							
5													
6	13	17	16	15	14	13							
7													
8	19	20	21	22	23	24							
9													
10	30	29	28	27	26	25							
11													
12	31	32	33	34	35	36							
13													

I, M.P. DAVIS, in a field survey on SEPTEMBER, 19 97, do hereby certify that under requirements of P.A. 74, Michigan P.A. of 1970, the corner points mentioned in lines 1 and 2 above were in conformance with regulations and rules therefore as required in the current manual of survey instructions of the United States Department of the Interior, Bureau of Land Management or by a decree of a Court of Law and/or that the corner points mentioned in lines 3, 4 and 5 above were in conformance with the rules of the Michigan Board of Land Surveyors or by a Decree of a Court of Law; established, re-established, monumented, re-monumented, recovered, found as expressed below:

**NOTE: Not more than 4 corners, all in the same town and range, may be recorded on this certificate.**

A. Description of original monument and accessories and/or subsequent restoration:


B-07 [N1/4 COR S19] A.MERRYWEATHER, D.S. - 1848- WOOD POST- (BEECH 10"-S84°W-08 LINKS) (BEECH 04"-N48°W-17 LINKS)  
NO RECORD EVIDENCE OF CORNER RECOVERY OR SUBSEQUENT MONUMENTATION

C-08 [W1/4 COR S19] A.MERRYWEATHER, D.S.-1848-WOOD POST (BEECH 04"-S84°W-08 LINKS) (IRONWOOD 07"-N75°E-12 LINKS)  
M.S.McNABB-1920-WOOD STAKE IN PLACE (NO WIT'S NOTED)

B. Description of corner evidence found and/or method applied in restoring or reestablishing corner:

B-07 [N1/4 COR S.19] FOUND IN PLACE, 24" BELOW ROAD SURFACE, 3/4" IRON PIN & REMAINS OF A WOOD POST SET IN A BRICK MOUND.

C-08 [W1/4 COR S.20] NO CORNER EVIDENCE FOUND AS ALL APPARENTLY HAS BEEN DESTROYED IN COUNTY ROAD CONSTRUCTION & IMPROVEMENTS. ESTABLISHED CORNER POSITION IN LINE WITH ANCIENT FARM FENCE TO THE EAST & IN THE CENTER LINE OF THE N-S COUNTY ROAD. THIS POSITION GIVES THE BEST FIT TO McNABB'S 1920 SURVEY IN THE EAST 1/2 OF SECTION 20.

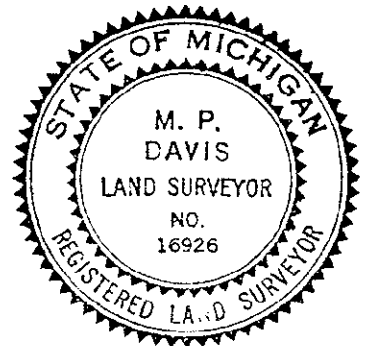

C. Description of monument for corner and accessories established to perpetuate locating the position of the corner:

B-07 SET OVER EXISTING IRON PIN A 5/8" X 18" REBAR W/A 3 1/4" ALUM CAP STAMPED TO ID THE CORNER POSITION & SET 6" BELOW RD GRADE.  

DRILL HOLE IN LARGE STONES	POWER POLE	SURVEY MONUMENT SIGN POST
N54°E	S45°W	N50°W
38.10'	48.71'	60.42' (TO FACE)

C-08 SET, 6" BELOW GRADE, A 5/8" X 18" REBAR W/A 3 1/4" ALUM CAP STAMPED TO ID THE CORNER POSITION.  

CHISELED CROSS ON LARGE STONES	NOTE: FARM FIELDS IN ALL FOUR QUAD'S.
N28°W	S67°W
59.30'	53.10'

NO OTHER WIT'S AVAILABLE.

NOTE: BEARINGS TO REFERENCE OBJECTS ARE MAGNETIC - DISTANCES ARE TO A NAIL IN THE CENTER OF THE OBJECT UNLESS NOTED OTHERWISE

Signed by M.P. Davis Date 10/27/97

Surveyor's Michigan License No. 16926