

# SURVEY & REMONUMENTATION

JAN 14 1998

SECTION

## LAND CORNER RECORDATION CERTIFICATE

Filing Requirement of Act 74, Mich. P.A. 1970

Approved By Delta County  
Land Survey Remonumentation  
Peer Group Under Act 345 Of  
P.A. Of 1990 On October 21, 1997  
*Robert B. ...*  
Chairman

For corners in  
DELTA  
(County)

Located In: Corner Code #

- |                                    |                         |             |
|------------------------------------|-------------------------|-------------|
| 1. Public Land Survey              | T 38 N R 19 W           | D-07 & D-09 |
|                                    | T _____ R _____         | _____       |
|                                    | T _____ R _____         | _____       |
|                                    | T _____ R _____         | _____       |
| 2. Property Controlling in Section | S _____ T _____ R _____ | _____       |
|                                    | S _____ T _____ R _____ | _____       |
| 3. Miscellaneous Property in Sec.  | S _____ T _____ R _____ | _____       |
|                                    | S _____ T _____ R _____ | _____       |

Recorded Nov 5 1997  
at 9:00 o'clock AM  
Book 8 Page 238  
*William C. Thorne*  
Registering Surveyor

Register of Deeds Stamp & File Number

4. Lot No. \_\_\_\_\_, Recorded Plat \_\_\_\_\_
5. Private Claims D-07 [N1/4 COR S20] D-09 [N1/4 COR S29]

A	B	C	D	E	F	G	H	I	J	K	L	M
2	6	5	4	3	2	1						
3												
4	7	8	9	10	11	12						
5												
6	18	17	16	15	14	13						
7												
8	19	20	21	22	23	24						
9												
10	30	29	28	27	26	25						
11												
12	31	32	33	34	35	36						
13												

I, M.P. DAVIS, in a field survey on SEPTEMBER, 19 97, do hereby certify that under requirements of P.A. 74, Michigan P.A. of 1970, the corner points mentioned in lines 1 and 2 above were in conformance with regulations and rules therefore as required in the current manual of survey instructions of the United States Department of the Interior, Bureau of Land Management or by a decree of a Court of Law and/or that the corner points mentioned in lines 3, 4 and 5 above were in conformance with the rules of the Michigan Board of Land Surveyors or by a Decree of a Court of Law; established, re-established, monumented, re-monumented, recovered, found as expressed below:

**NOTE: Not more than 4 corners, all in the same town and range, may be recorded on this certificate.**

A. Description of original monument and accessories and/or subsequent restoration:


D-07 [N1/4 COR S20] A.MERRYWEATHER, D.S. - 1848-WOOD POST- (SUGAR 06°-S70°W-11 LINKS) (BIRCH 09°-N51°E-24 LINKS) M.S.McNABB-1920-FOUND IN PLACE STAKE SCRIBED "1/4" WITH STONES PILED AROUND IT. NO NEW WIT'S NOTED.

D-09 [N1/4 COR S29] A.MERRYWEATHER, D.S.-1848-WOOD POST- (BALSAM 07°-N10°E-51 LINKS) (IRONWOOD 08°-S20°W 09 LINKS) M.S.McNABB-1920-NO COR FOUND, ESTABLISHED 1/2 DISTANCE BETWEEN CORNERS (POPLAR 10° N22°E 5.5')(CEDAR STUB 16° N40°W 15.6').

B. Description of corner evidence found and/or method applied in restoring or reestablishing corner:

D-07 [N1/4 COR S.20] NO CORNER EVIDENCE FOUND. REESTABLISHED CORNER POSITION BY DISTANCE-DISTANCE INTERSECTION UTILIZING McNABB'S RECORD DISTANCE WEST OF THE NE CORNER OF SECTION 20 AND NORTH OF THE S1/4 CORNER OF SEC 20. CORNER POSITION FALLS 5' M/L NORTH OF THE C/L OF THE E-W COUNTY ROAD & IN LINE WITH ANCIENT FENCE LINES N & S. ACCEPTED AS BEING THE BEST AVAILABLE EVIDENCE AS TO THE POSITION OF THE ORIGINAL CORNER.

D-09 [N1/4 COR S.29] NO CORNER EVIDENCE FOUND. REESTABLISHED CORNER POSITION ON LINE WITH & AT THE MIDPOINT BETWEEN CORNERS AS PER THE RECORDS OF McNABB.

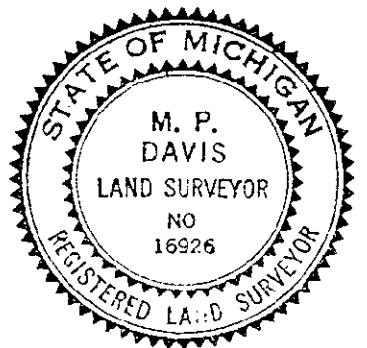

C. Description of monument for corner and accessories established to perpetuate locating the position of the corner:

D-07 SET, AT GRADE, A 5/8" X 18" REBAR W/A 3 1/4" ALUMN CAP STAMPED TO ID THE CORNER POSITION.  

CEDAR 09"	CEDAR 07"	CEDAR 07"	POWER POLE
N32°W	N54°E	S06°E	S53°W
48.11'	38.75'	53.02'	60.10'

D-09 SET 5/8" X 18" REBAR W/A 3 1/4" ALUM CAP STAMPED TO ID THE CORNER POSITION.  

MAPLE 13"	MAPLE 08"	MAPLE 12"	IRONWOOD 06"
N65°W	N17°E	S61°W	N78°E
38.15'	29.28'	27.61'	42.35'

NOTE: BEARINGS TO REFERENCE OBJECTS ARE MAGNETIC - DISTANCES ARE TO A NAIL IN THE CENTER OF THE OBJECT UNLESS NOTED OTHERWISE

Signed by M.P. Davis Date 10/27/97  
Surveyor's Michigan License No. 16926