

SURVEY & REMONUMENTATION

OCT 08 2000

SECTION

LAND CORNER RECORDATION CERTIFICATE
 Filing Requirement of Act 74, Mich. P.A. 1970

Approved By Delta County
 Land Survey Remonumentation
 Peer Group Under Act 345 of
 P.A. Of 1990 On July 12, 2000
Robert Schmeling
 Acting Chairman

For corners in

DELTA (County)	Located In:	Corner Code #
1. Public Land Survey	T38 N R 19 W	D-11 ✓
	T38 N R 19 W	D-12
2. Property Controlling in Section	T R	
	T R	
3. Miscellaneous Property in Sec.	S T R	
	S T R	

RECORDED 28 July 2000
 AT 9:00 O'CLOCK a.m.
 LIBER 9 PAGE 224
William C. Thomas
 DELTA COUNTY MI REG. OF DEEDS

Register of Deeds Stamp & File Number

4. Lot No. _____, Recorded Plat _____
 5. Private Claims _____

A	B	C	D	E	F	G	H	I	J	K	L	M
1												
2	6	5	4	3	2							
3												
4	7	8	9	10	11	12						
5												
6	18	17	16	15	14	13						
7												
8	19	20	21	22	23	24						
9												
10	30	29	28	27	26	25						
11		•										
12	31	•	33	34	35	36						
13												

I, M.P. DAVIS, in a field survey on JUNE, 2000 do hereby state that under requirements of P.A. 74, Michigan P.A. of 1970, the corner points mentioned in lines 1 and 2 above were in conformance with regulations and rules therefore as required in the current manual of survey instructions of the United States Department of the Interior, Bureau of Land Management or by a decree of a Court of Law and /or that the corner points mentioned in lines 3, 4 and 5 above were in conformance with the rules of the Michigan Board of Land Surveyors or by a Decree of a Court of Law, established, re-established, monumented, recovered, found as expressed below:


NOTE: Not more than 2 corners, all in the same town and range, may be recorded on this certificate.

A. Description of original monument and accessories and/or subsequent restoration:

- D-11 [N1/4 COR SEC 32] ALGERNON MERRYWEATHER, D.S. - 1848-WOOD POST-(IRONWOOD 07" N50°E 07 LINKS)(IRONWOOD 06" S65°W 02 LINKS) C.E.BROTHERTON-1878-CORNER IN PLACE-NO WIT'S NOTED OR DESCRIPTION OF MONUMENT GIVEN.
 M.S.McNABB-1928-ROAD ALIGNMENT SURVEY FOR C.R. 483 AT STA 1149+24.4 - FOUND IRON PIN AT ABOUT THE 1/4 CORNER. FIGURED TO BE ABOUT 75'± NORTH OF DIRECT LINE BETWEEN CORNERS. (MAPLE 06" S64°E 35.6')(ELM 13" S25°W 38')
 T.O'BRIEN-1978-FOUND IRON BAR 4.1' WEST OF C/L OF C.R. 483 (FENCE POST N55°E 66.0')(FENCE POST N69°W 77.0')(PP S60°E 47.7')
- D-12 [C1/4 COR SEC 32] NOT SET IN ORIGINALS
 C.E.BROTHERTON-1878-SET STAKE AT INTERSECTION OF 1/4 LINES (MAPLE 10" S14°E 71 LINKS)

B. Description of corner evidence found and/or method applied in restoring or reestablishing corner:

- D-11 [N1/4 COR SEC 32] FOUND IN PLACE, AT THE JCT OF COUNTY ROADS N,S,E & W A 1-1/2" DOMED IRON PIN, 4'± W. OF THE C/L OF THE N-S COUNTY ROAD AND 66.5' EAST AND 67.8' NORTH OF THE MIDPOINT BETWEEN SEC CORNERS 1/2 MILE EAST AND WEST. ID EXISTING MONUMENT AS BEING THE SAME AS RECOVERED BY TOM O'BRIEN & REC'D AT LIBER 2 OF LCR'S PAGE 207. DISTANCES TO CORNERS 1/2 MILE WEST AND 1 MILE SOUTH CHECK WELL WITH THE RECORDS OF C.E.BROTHERTON. ACCEPTED EXISTING MONUMENT AS BEING THE BEST AVAILABLE EVIDENCE AS TO THE LOCATION OF THE POSITION OF THE ORIGINAL CORNER.
- D-12 [C1/4 COR SEC 32] NO CORNER EVIDENCE TO BE FOUND. REESTABLISHED CORNER POSITION AT JCT OF N-S AND E-W 1/4 LINES.

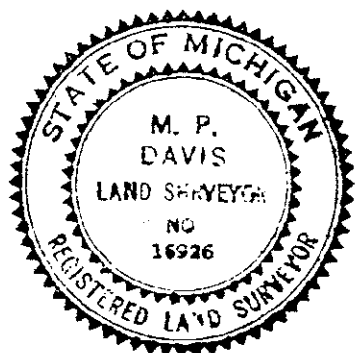

C. Description of monument for corner and accessories established to perpetuate locating the position of the corner:

- D-11 SET, OVER EXISTING MON, A 5/8" X 18" REBAR W/A 3-1/4" ALUM CAP STAMPED TO ID THE CORNER POSITION. RAISED TO GRADE W/A MON BOX
 SPRUCE 08" CEDAR 06" W.PINE 15" SPRUCE 06"
 N35°W N75°E S50°E S60°W
 73.95' 88.90' 89.27' 84.05'
- D-12 SET A 5/8" X 8" REBAR IN A DRILL IN LEDGE ROCK W/A 3-1/4" ALUM CAP STAMPED TO ID THE CORNER POSITION.
 SPRUCE 09" POWER POLE MAPLE 14" SPRUCE 13" C/L COUNTY ROAD 483
 N51°W N23°E S66°E S54°W WEST
 63.94' 30.85' 54.98' 81.12' 24.5'

NOTE: BEARINGS TO REFERENCE OBJECTS ARE MAGNETIC-DISTANCES ARE TO A NAIL W/A DELTA COUNTY REFERENCE TAG, UNLESS OTHERWISE NOTED.

Signed by M.P. Davis Date 7/13/00
 Surveyor's Michigan License No. 16926