

**SURVEY & REMONUMENTATION**

**JAN 14 1998**

**SECTION**

**LAND CORNER RECORDATION CERTIFICATE**  
**Filing Requirement of Act 74, Mich. P.A. 1970**

Approved By Delta County  
 Land Survey Remonumentation  
 Peer Group Under Act 345 Of  
 P.A. Of 1990 On October 31, 1997  
*Robert Helmeling*  
 Chairman

For corners in  
DELTA  
 (County)

Located In:

Corner Code #

- |                                    |   |             |   |             |                        |
|------------------------------------|---|-------------|---|-------------|------------------------|
| 1. Public Land Survey              | T | <u>38 N</u> | R | <u>19 W</u> | <u>E-08 &amp; E-09</u> |
|                                    | T |             | R |             |                        |
|                                    | T |             | R |             |                        |
|                                    | T |             | R |             |                        |
| 2. Property Controlling in Section | S |             | T | R           |                        |
|                                    | S |             | T | R           |                        |
| 3. Miscellaneous Property in Sec.  | S |             | T | R           |                        |
|                                    | S |             | T | R           |                        |

REGISTERED  
Nov 5 1997  
9:00 AM  
8 241  
*Walter C. Thorne*

Register of Deeds Stamp & File Number

4. Lot No. \_\_\_\_\_, Recorded Plat \_\_\_\_\_
5. Private Claims E-08 [W1/4 COR S21] E-09 [NW COR S28]

A	B	C	D	E	F	G	H	I	J	K	L	M
2	6	5	4	3	2	1						
3												
4	7	8	9	10	11	12						
5												
6	13	17	16	15	14	13						
7												
8	19	20	21	22	23	24						
9												
10	30	29	28	27	26	25						
11												
12	31	32	33	34	35	36						
13												

I, M.P. DAVIS in a field survey on SEPTEMBER, 19 97, do hereby certify that under requirements of P.A. 74, Michigan P.A. of 1970, the corner points mentioned in lines 1 and 2 above were in conformance with regulations and rules therefore as required in the current manual of survey instructions of the United States Department of the Interior, Bureau of Land Management or by a decree of a Court of Law and/or that the corner points mentioned in lines 3, 4 and 5 above were in conformance with the rules of the Michigan Board of Land Surveyors or by a Decree of a Court of Law; established, re-established, monumented, re-monumented, recovered, found as expressed below:


**NOTE: Not more than 4 corners, all in the same town and range, may be recorded on this certificate.**

- A. Description of original monument and accessories and/or subsequent restoration:
- E-08 [W1/4 COR S21] A.MERRYWEATHER, D.S. - 1848-WOOD POST- (BIRCH 08"-S54'E-09 LINKS) (BIRCH 08"-N60'W-22 LINKS) M.S.McNABB-1920-ORIGINALS DESTROYED SET IRON BOLT 1/2 DIST BETWEEN CORNERS-BT STAKES NE & SW 33'
- E-09 [NW COR S28] A.MERRYWEATHER, D.S.-1848-WOOD POST- (BIRCH 07"-S55'E-10 LINKS) (CEDAR 08"-N65'E-11 LINKS) M.S.McNABB-1920-STAKE IN PLACE "ORIGINALS PLAIN" NO OTHER WIT'S NOTED

B. Description of corner evidence found and/or method applied in restoring or reestablishing corner:

E-08 [W1/4 COR S.21] NO CORNER EVIDENCE FOUND. REESTABLISHED CORNER POSITION ON LINE WITH AND AT THE MIDPOINT BETWEEN SEC COR'S 1/2 MILE N & S. DISTANCE BETWEEN SEC COR'S CHECKS WELL WITH THE RECORDS OF McNABB.

E-09 [NW COR S.28] FOUND IN PLACE A 1/2" X 18" IRON PIN W/A T.OBRIEN SURVEY CAP. MR. OERIEIN INFORMED ME THAT HE HAD SET THE SAME FROM CORNER MONUMENTATION FOUND BY HIMSELF ALONG THE SOUTH LINE OF SEC 21. DISTANCES FROM THIS CORNER CHECK WELL TO McNABB'S CORNER FOUND 1 MILE TO THE WEST AND THE MASONARY NAIL 1 MILE TO THE NORTH. ACCEPTED THE EXISTING MONUMENT AS BEING THE BEST AVAILABLE EVIDENCE AS TO THE LOCATION OF THE POSITION OF THE ORIGINAL CORNER.

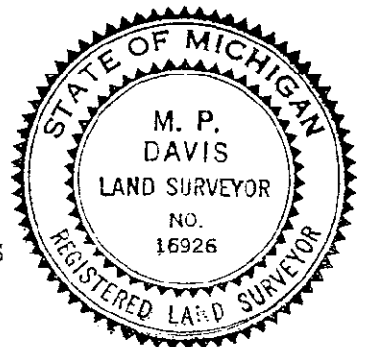

C. Description of monument for corner and accessories established to perpetuate locating the position of the corner:

E-08 SET, 6" BELOW GRADE, A 5/8" X 18" REBAR W/A 3 1/4" ALUMN CAP STAMPED TO ID THE CORNER POSITION.

CEDAR 07"	MAPLE 22"	MAPLE 24"	C/L N-S COUNTY ROAD
N74°W	N28°E	S56°E	WEST
58.16'	37.33'	75.05'	13'

E-09 SET OVER EXISTING MONUMENT A BERNTSEN ALNB30 ALUM MONUMENT WITH THE CAP STAMPED TO ID THE CORNER POSITION.

CEDAR 13"	CEDAR 08"	BALM OF GILEAD 08"	SURVEY MONUMENT SIGN POST
S21°E	S28°W	N24°E	N40°W
35.15'	43.52'	5.74'	2.17'

NOTE: BEARINGS TO REFERENCE OBJECTS ARE MAGNETIC - DISTANCES ARE TO A NAIL IN THE CENTER OF THE OBJECT UNLESS NOTED OTHERWISE

Signed by M.P. Davis Date 10/27/97  
 Surveyor's Michigan License No. 16926