

SURVEY & REMONUMENTATION

OCT 03 2000

SECTION

Approved By Delta County
Land Survey Remonumentation
Peer Group Under Act 345 of
P.A. Of 1990 On July 12, 2000
Robert Shindler
acting Chairman

LAND CORNER RECORDATION CERTIFICATE
Filing Requirement of Act 74, Mich. P.A. 1970

For corners in

<u>DELTA</u> (County)	Located In:	Corner Code #
1. Public Land Survey	T 38 NR 19 W	G-13 SAME
	T 37 NR 19 W	G-01 CORNER
	T 38 NR 19 W	H-13 SAME
	T 37 NR 19 W	H-01 CORNER
2. Property Controlling in Section	S _____ T _____ R _____	_____
3. Miscellaneous Property in Sec.	S _____ T _____ R _____	_____
	S _____ T _____ R _____	_____
	S _____ T _____ R _____	_____
4. Lot No. _____, Recorded Plat _____		
5. Private Claims _____		

RECORDED 28 July 2000
AT 9:00 O'CLOCK a.m.
LIBER 9 PAGE 234
Walter C. Thuman
DELTA COUNTY MI REG. OF DEEDS
Register of Deeds Stamp & File Number


	A	B	C	D	E	F	G	H	I	J	K	L	M
1													
2	6	5	4	3	2	1							
3													
4	7	8	9	10	11	12							
5													
6	18	17	16	15	14	13							
7													
8	19	20	21	22	23	24							
9													
10	30	29	28	27	26	25							
11													
12	31	32	33	34	35	36							
13													

I, M.P. DAVIS, in a field survey on JUNE, 2000 do hereby state that under requirements of P.A. 74, Michigan P.A. of 1970, the corner points mentioned in lines 1 and 2 above were in conformance with regulations and rules therefore as required in the current manual of survey instructions of the United States Department of the Interior, Bureau of Land Management or by a decree of a Court of Law and/or that the corner points mentioned in lines 3, 4 and 5 above were in conformance with the rules of the Michigan Board of Land Surveyors or by a Decree of a Court of Law; established, re-established, monumented, recovered, found as expressed below:

NOTE: Not more than 2 corners, all in the same town and range, may be recorded on this certificate.

- A. Description of original monument and accessories and/or subsequent restoration:
- G-13 [SW COR SEC 34] ALGERNON MERRYWEATHER, D.S.-1848-CEDAR 10" CORNER TREE-(WILLOW 08" N35°E 23 LINKS)(CEDAR 12" N55°W 31 LINKS)
M.S.McNABB-1916-ID FROM ORIGINALS, SET BT STAKES NW & SE 33'
M.S.McNABB-1920-IRON BOLT AND BT STAKES IN PLACE FROM PREVIOUS SURVEY
 - H-13 [S1/4 COR SEC 34] ALGERNON MERRYWEATHER, D.S.-1848-WOOD POST-(CEDAR 07" S22°W 09 LINKS)(BALSAM 06" N10°E 10 LINKS)
M.S.McNABB-1916-ID BY STAKE IN PLACE (POPLAR N79°E 21.2')(POPLAR 05" N2°W 24.2')

- B. Description of corner evidence found and/or method applied in restoring or reestablishing corner:
- G-13 [SW COR SEC 34] NO CORNER EVIDENCE FOUND. RECOVERED McNABB'S 1920 S1/4 & W1/16 COR'S ON THE SOUTH LINE OF SEC 34 & REESTABLISHED THE SEC CORNER ON THIS LINE AND AT PROPORTIONATE DISTANCE WEST OF THE W1/16. ACCEPTED THIS POSITION AS BEING THE BEST AVAILABLE EVIDENCE AS TO THE LOCATION OF THE POSITION OF THE ORIGINAL CORNER.
 - H-13 [S1/4 COR SEC 34] NO CORNER EVIDENCE FOUND. RECOVERED McNABB'S 1920 SE & E1/16 COR'S ON THE SOUTH LINE OF SEC 34 & REESTABLISHED THE 1/4 COR ON THIS LINE AND AT PROPORTIONATE DISTANCE WEST OF THE EAST 1/16. ACCEPTED THIS POSITION AS BEING THE BEST AVAILABLE EVIDENCE AS TO THE LOCATION OF THE POSITION OF THE ORIGINAL CORNER.

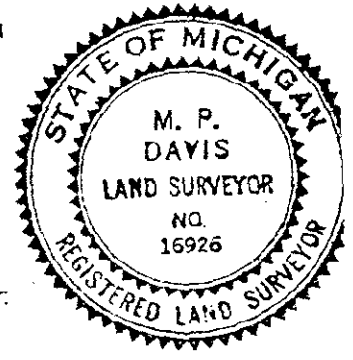

- C. Description of monument for corner and accessories established to perpetuate locating the position of the corner:
- G-13 SET A 5/8" X 18" REBAR W/A 3-1/4" ALUM CAP STAMPED TO ID THE CORNER POSITION.
CEDAR 06" SURVEY MONUMENT SIGN POST C/L OF E-W WOODS ROAD
N50°E NORTH SOUTH
34.05' 45.95' 4.02' (TO FACE) 6.5'
 - H-13 NO MON SET. COR POSITION IN LARGE DEPRESSION IN E-W WOODS RD. WITH LEDGE ROCK AT THE SURFACE.
CEDAR 11" CEDAR 05" CEDAR 06" CEDAR 06"
N21°W N29°E S73°E S50°W
73.25' 66.55' 19.83' 41.59'

NOTE: BEARINGS TO REFERENCE OBJECTS ARE MAGNETIC-DISTANCES ARE TO A NAIL W/A DELTA COUNTY REFERENCE TAG, UNLESS OTHERWISE NOTED.

Signed by M.P. Davis
Surveyor's Michigan License No. 16926

Date 7/13/00